


Sec 16
York

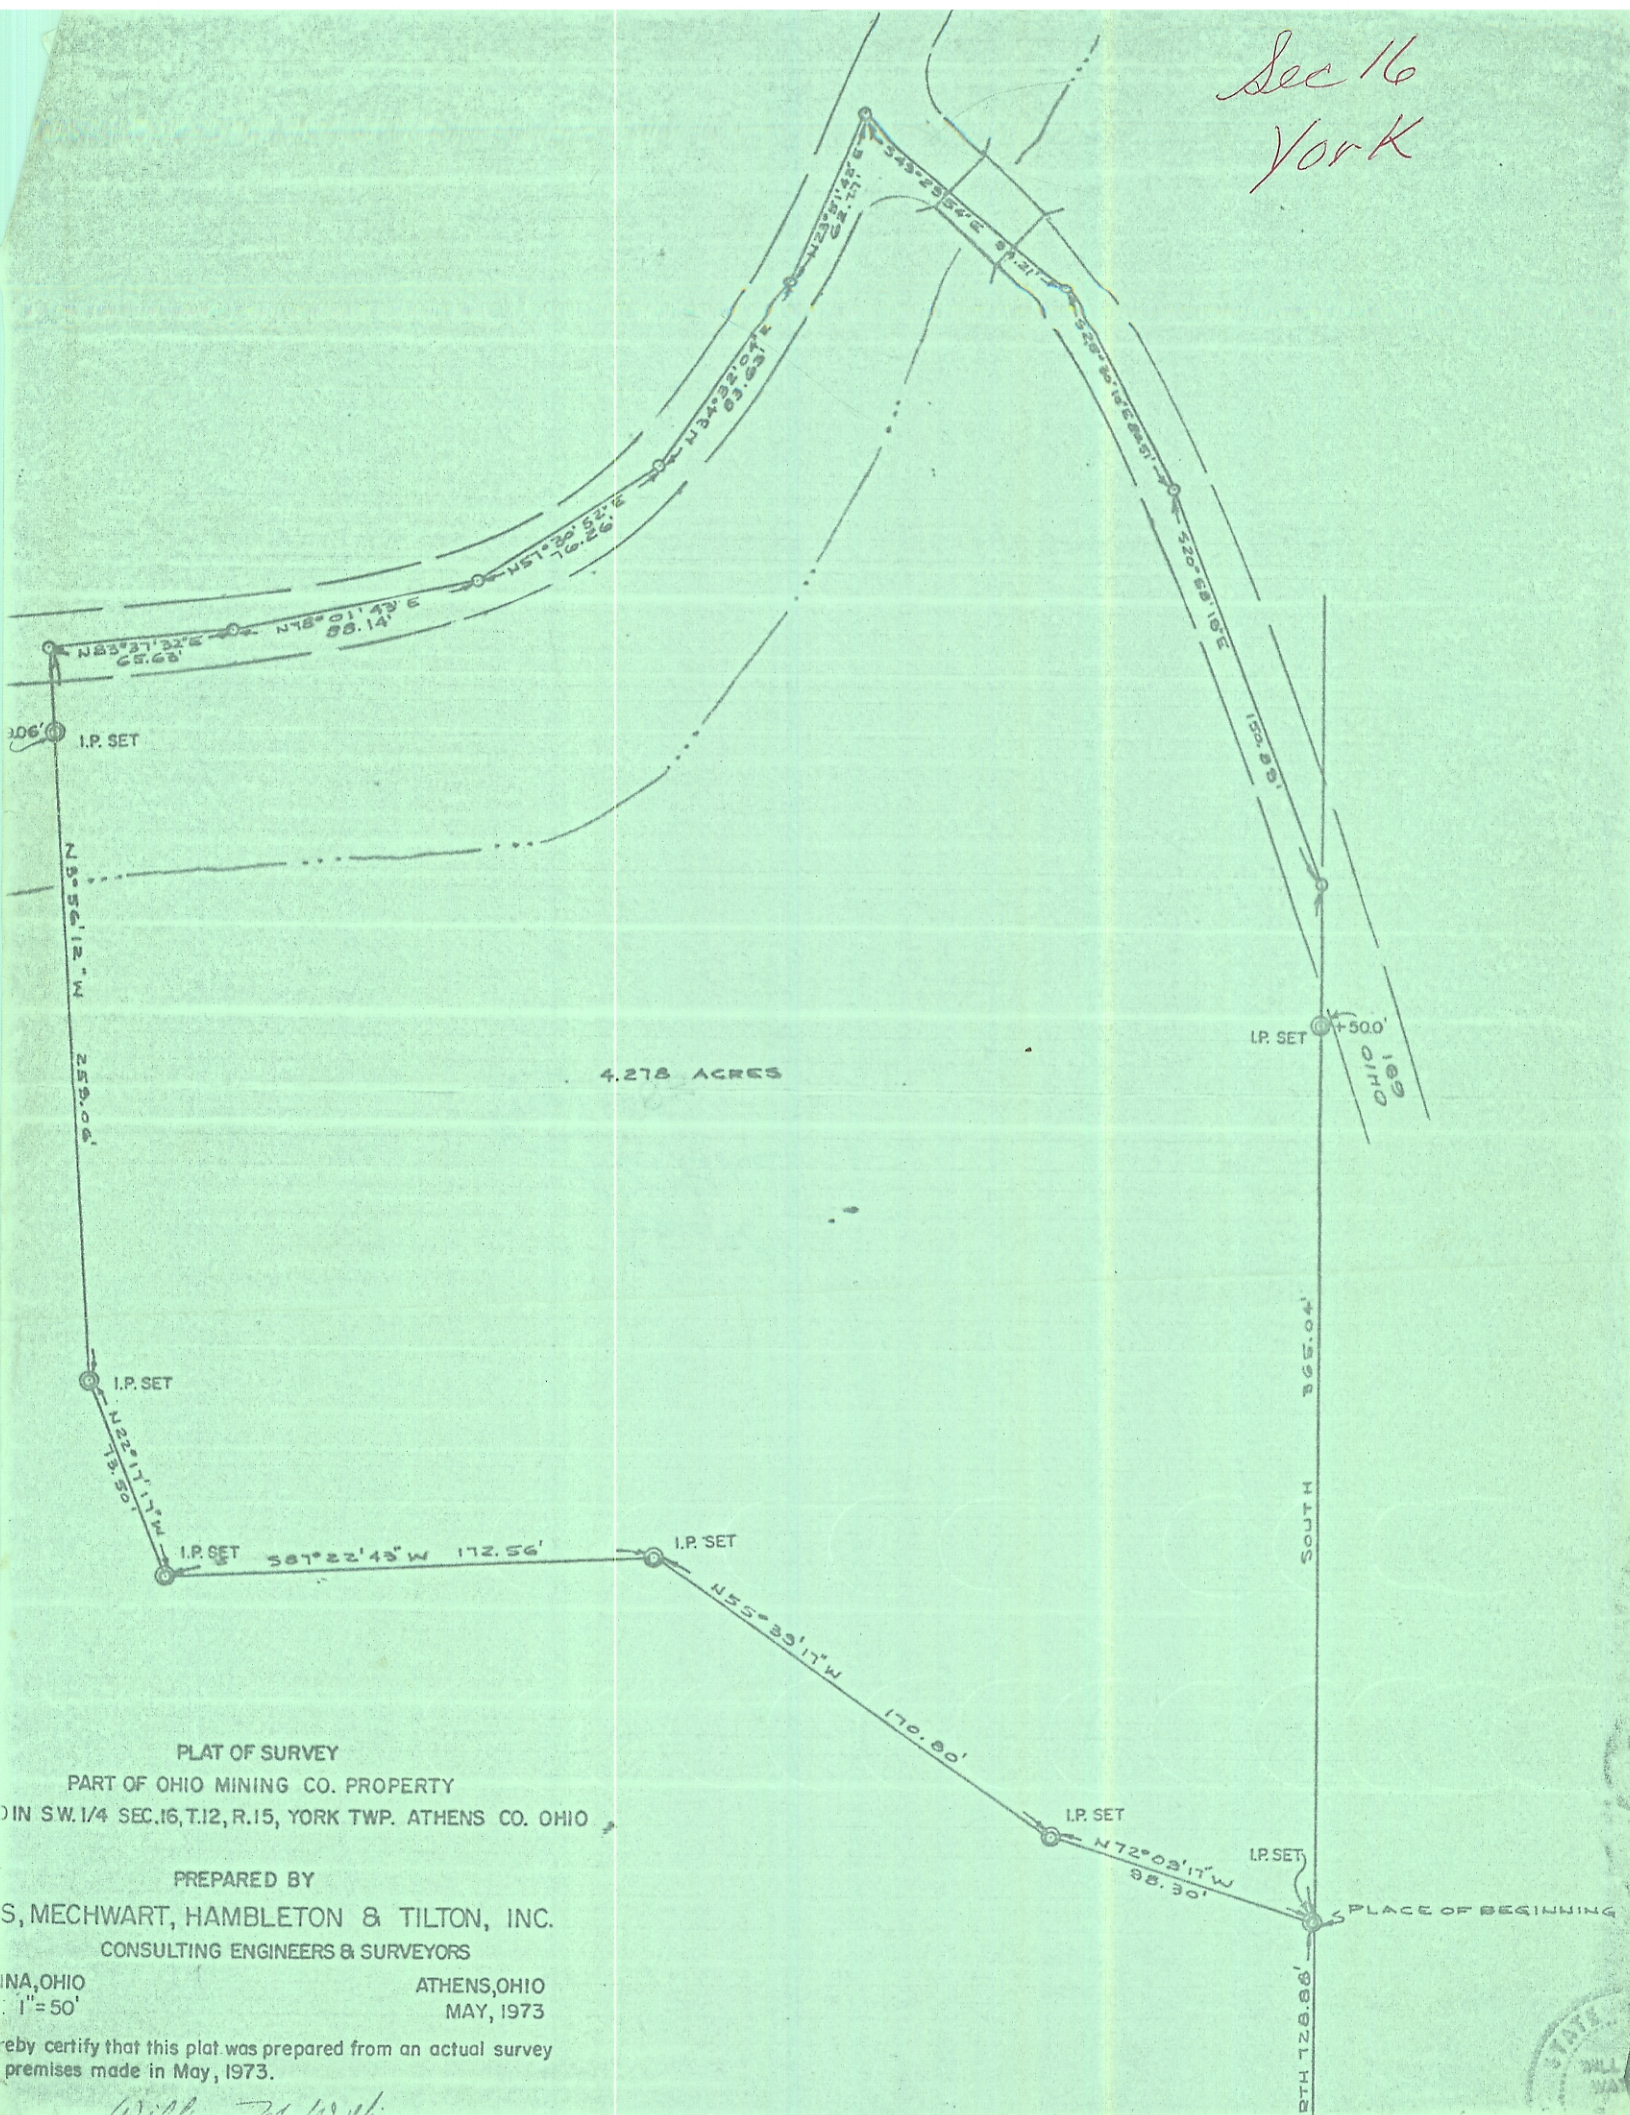

PLAT OF SURVEY

PART OF OHIO MINING CO. PROPERTY

IN SW 1/4 SEC. 16, T. 12, R. 15, YORK TWP. ATHENS CO. OHIO

PREPARED BY

S, MECHWART, HAMBLETON & TILTON, INC.

CONSULTING ENGINEERS & SURVEYORS


ATHENS, OHIO

1" = 50'

MAY, 1973

we hereby certify that this plat was prepared from an actual survey of the premises made in May, 1973.

Handwritten signature/initials

