
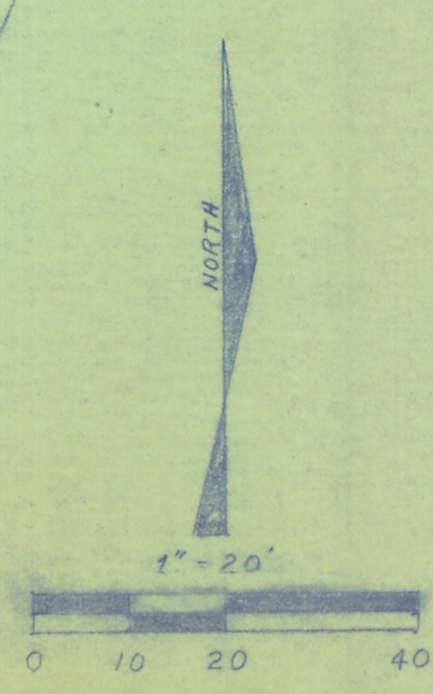


PART OF LOT No. 663 IN LEVI SKIVERS' ADDITION  
 IN  
 THE CITY OF NELSONVILLE, YORK TOWNSHIP, ATHENS COUNTY, OHIO

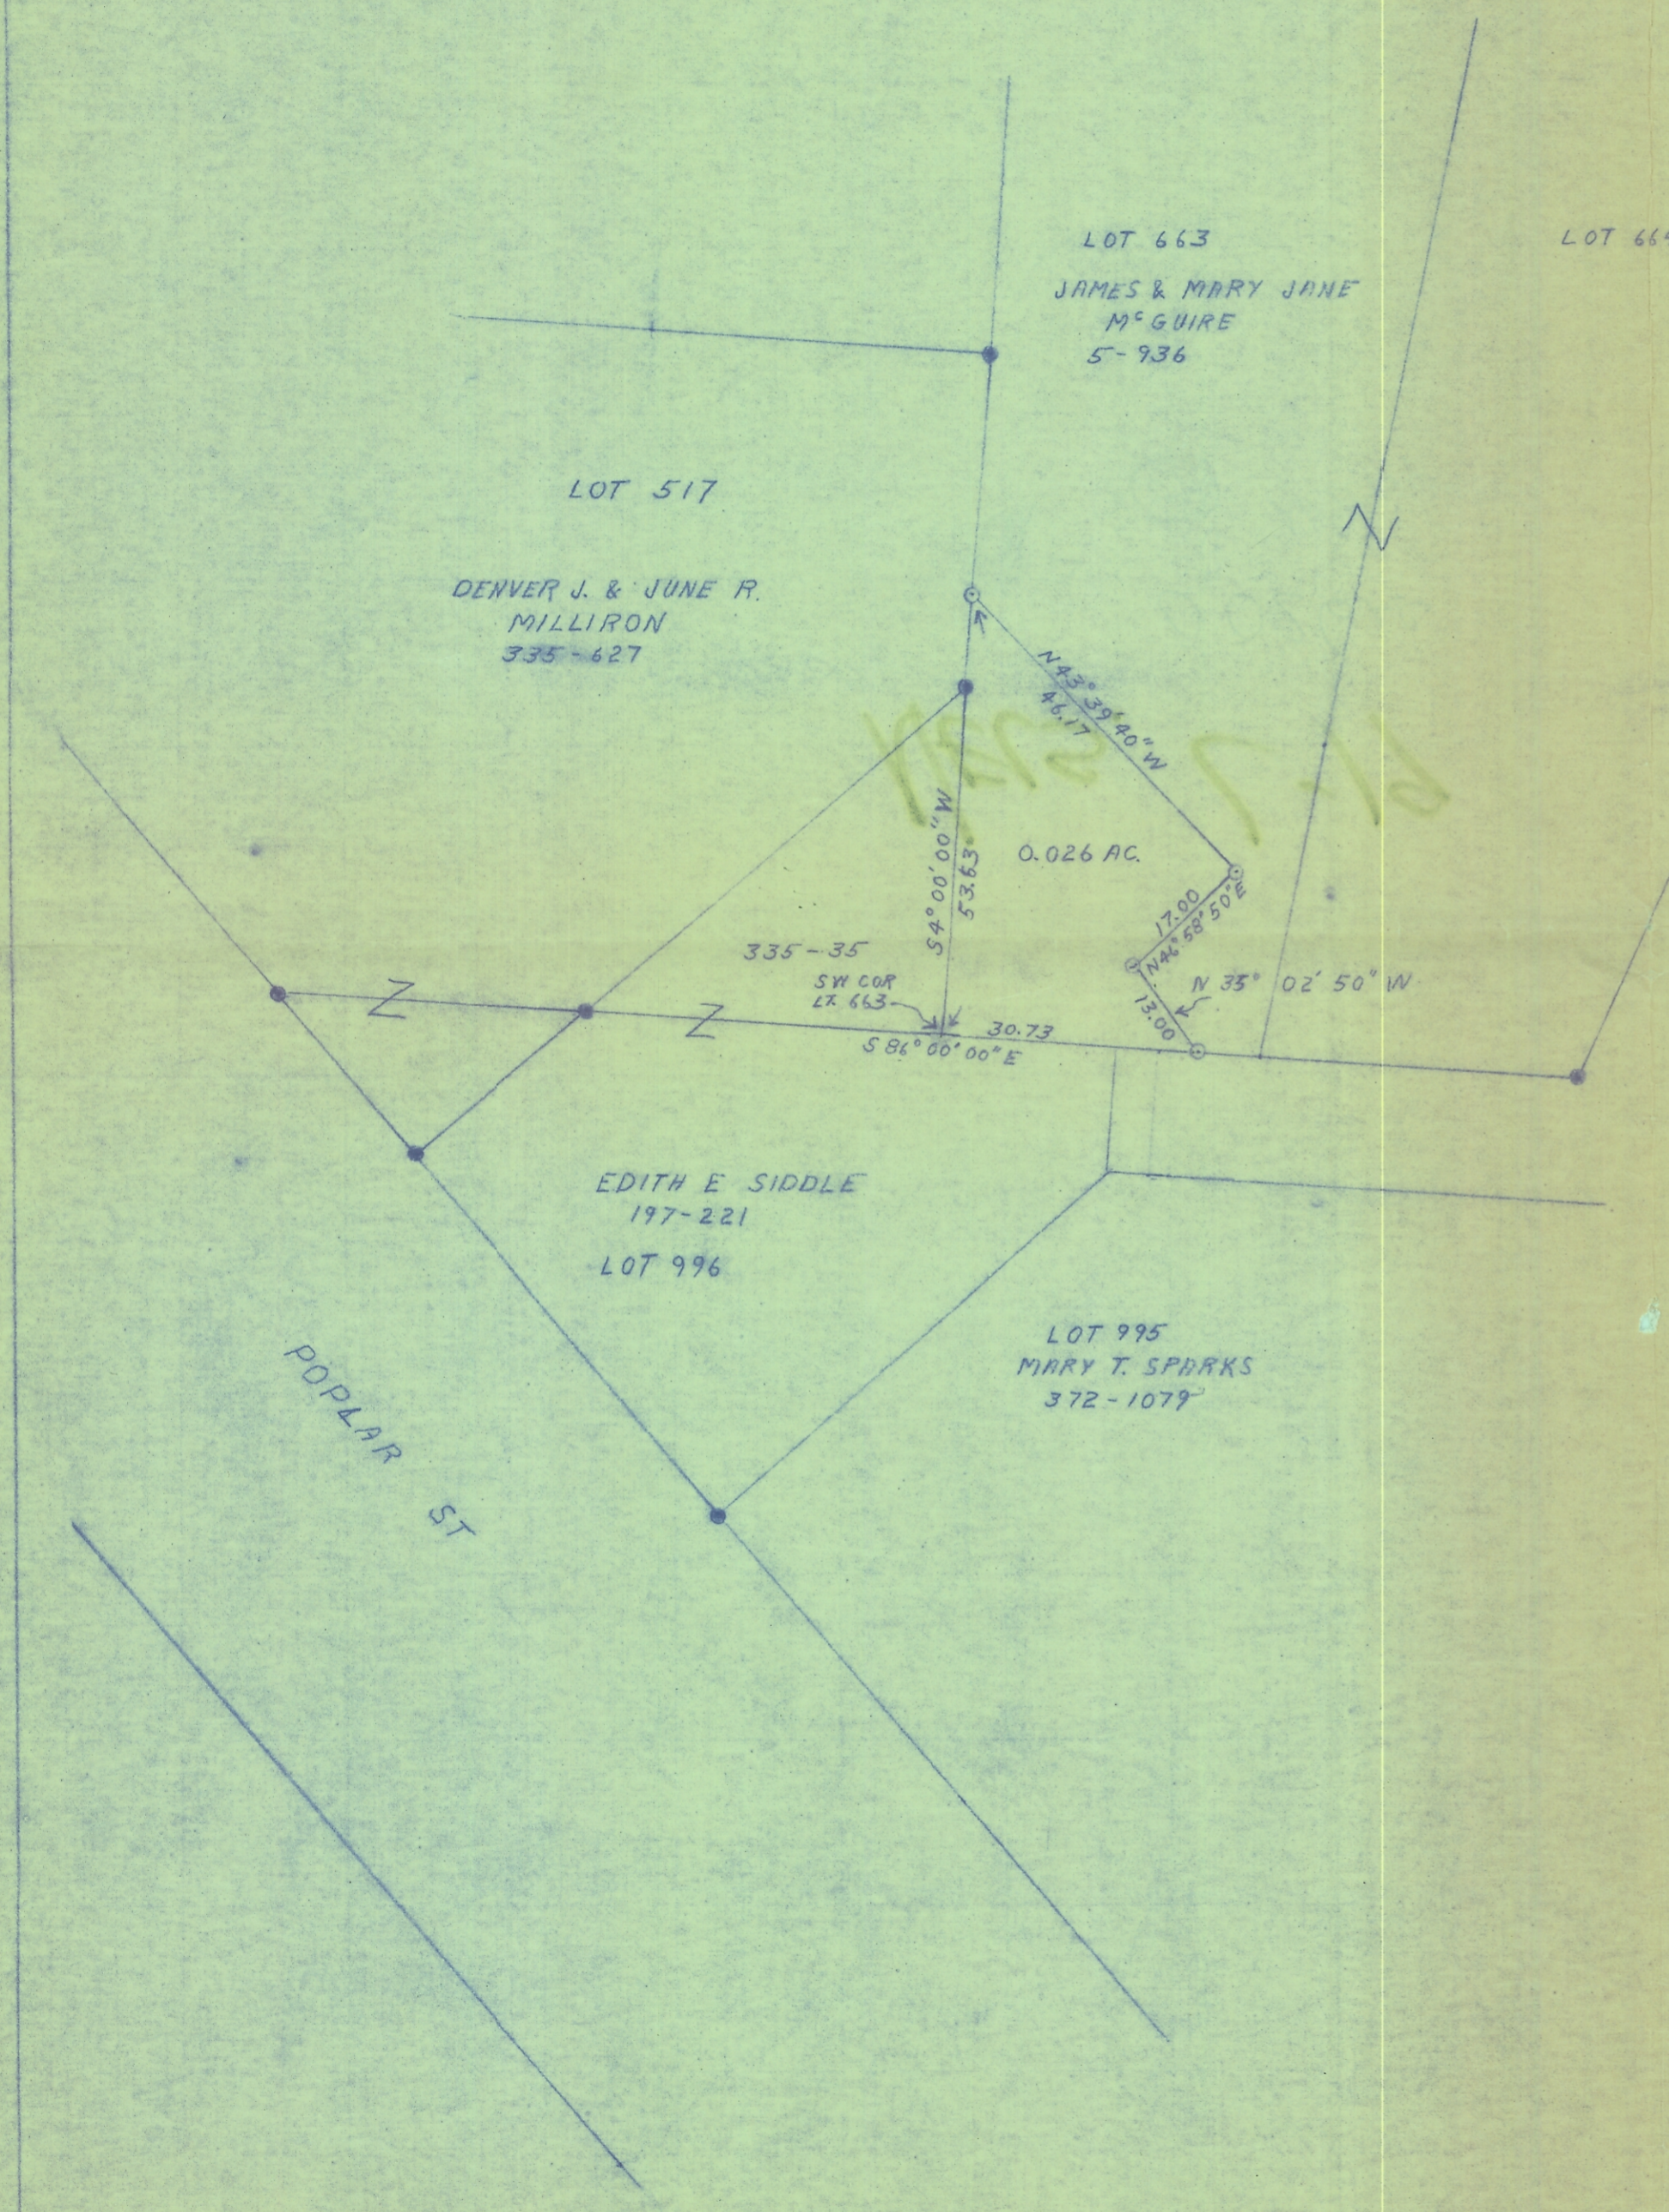

- IRON PIN FOUND
- IRON PIN W/ 1/4" PLASTIC IDENTIFICATION CAPS

- REFERENCES:
1. EXISTING DEEDS
  2. VARIOUS PLATS

BEARING REFERENCE:  
 SOUTH LINE LOT 663 ASSUMED S 86° 00' 00" E

I HEREBY CERTIFY THAT THIS PLAT  
 WAS PREPARED FROM AN ACTUAL SURVEY  
 OF THE PREMISES MADE BY ME IN JANUARY,  
 1990.

*Joseph C. Roman*  
 JOSEPH C. ROMAN REGISTERED SURVEYOR NO. 5-6461

Description checked for  
 Mathematical Accuracy  
 ATHENS COUNTY  
 ENGINEER'S OFFICE  
 BY: *Chris Colton*  
 DATE: 3-5-90

SEARCHED  
 INDEXED  
 SERIALIZED  
 FILED  
 APR 25 1990  
 ATHENS COUNTY  
 REC'D