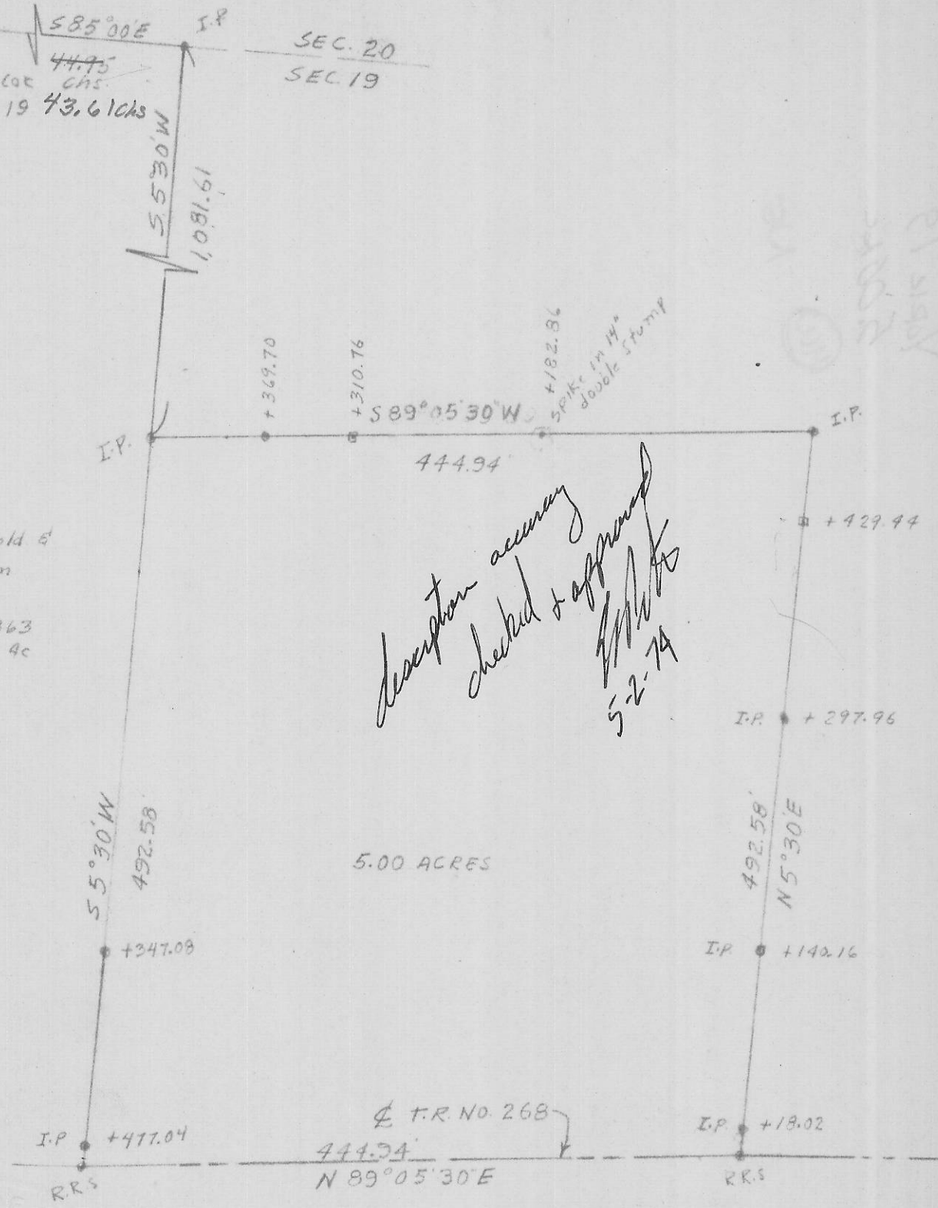

SURVEY OF A 5.00 ACRE TRACT IN SEC. 19, T. 12, R. 15, YORK TWP., ATHENS COUNTY, OHIO for E.A. COTTINGHAM

SURVEYED APRIL 23, 1974 by HAROLD D. WHALEY

Harold D. Whaley

REG. SURVEYOR NO. 4986

3" = 1'