


HIGHLAND SURVEYING Ltd.  
Registered Professional Land Surveyor

EXHIBIT  
"B"

LOT  
2000

Howson  
286-2652 OR

Porter  
365-649 OR

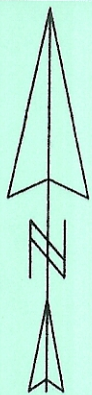

+2.00'

L1

N 48°01'32"W  
36.68'

S 60°16'36"E  
160.84'

N 44°19'28"W  
48.68'

Pine Grove Dr.

0.121 Ac.

Pine Grove  
Apts. Ltd.  
102-930 OR

Rosa L. Vaughn  
Property Vacated Ordinance  
11-62 on 11-14-1960

+158.74'

○=Iron Pin Set

●=Iron Pin Found

Scale 1"=30'



M 8°28'38"W  
50.50'

+30.00'

Sagen  
301-1139 OR

+31.80'

S 89°21'38"W  
33.80'

N 30°23'35"W  
31.55'

N 29°47'47"W  
33.11'

Line	Bearing	Distance
1	N 52°51'19"W	14.27'
2	N 18°46'28"E	6.99'

Description Checked for  
Mathematical Accuracy  
Athens County  
ENGINEER'S OFFICE

BY: S. Blausch  
DATE: 3-8-07

PLAT OF SURVEY OF A 0.121 AC. TRACT

SURVEYED FOR JOEL PORTER

SUBDIVISION VAUGHN BROTHERS

TOWNSHIP YORK SECTION 24 TOWN 12 RANGE 1S

CORPORATION NELSONVILLE COUNTY ATHENS STATE OHIO

SCALE 1"= 30' DATE MAR 2007

Kenneth E. Highland  
80 Fayette St.  
Nelsonville, Ohio 45764  
740-753-1264



Kenneth E. Highland S-7581