Side Trk. No.	Location	Class	Length K.S.M. 100'	Joint	Private	Total	Remarks
	Athens Twp. Athens Co.						

No.	Grantor	Grantee	Instrument	Date	Record	Cust. No.	
1	Jewett Heirs	O.C.R.R.Co.	Voucher	Feb.13, 1882.		77	Accounting records show the payment of $550.00 to Jewett Heirs for this parcel but deed cannot be located.
2	No. paper	title found				78	Held by adverse possession and claimed by Ry. Co.
3	Peter Martin	O.C.R.R.Co.	Voucher	Dec.16, 1881.		79	Accounting records show the payment of $340.00 to Peter Martin for this parcel but deed cannot be located.
4	Joseph Dorr	"	"	Feb.18, 1882.		80	" " " " " " $650.00 " Joseph Dorr " " " " " " " "
5	Henry Lohse	"	"	Dec. 4, 1881.		81	" " " " " " $400.00 " Henry Lohse " " " " " " " "
6	Hiram Armitage	"	"	Feb.20, 1882.		82	" " " " " " $1611.00 " Hiram Armitage " " " " " " " "

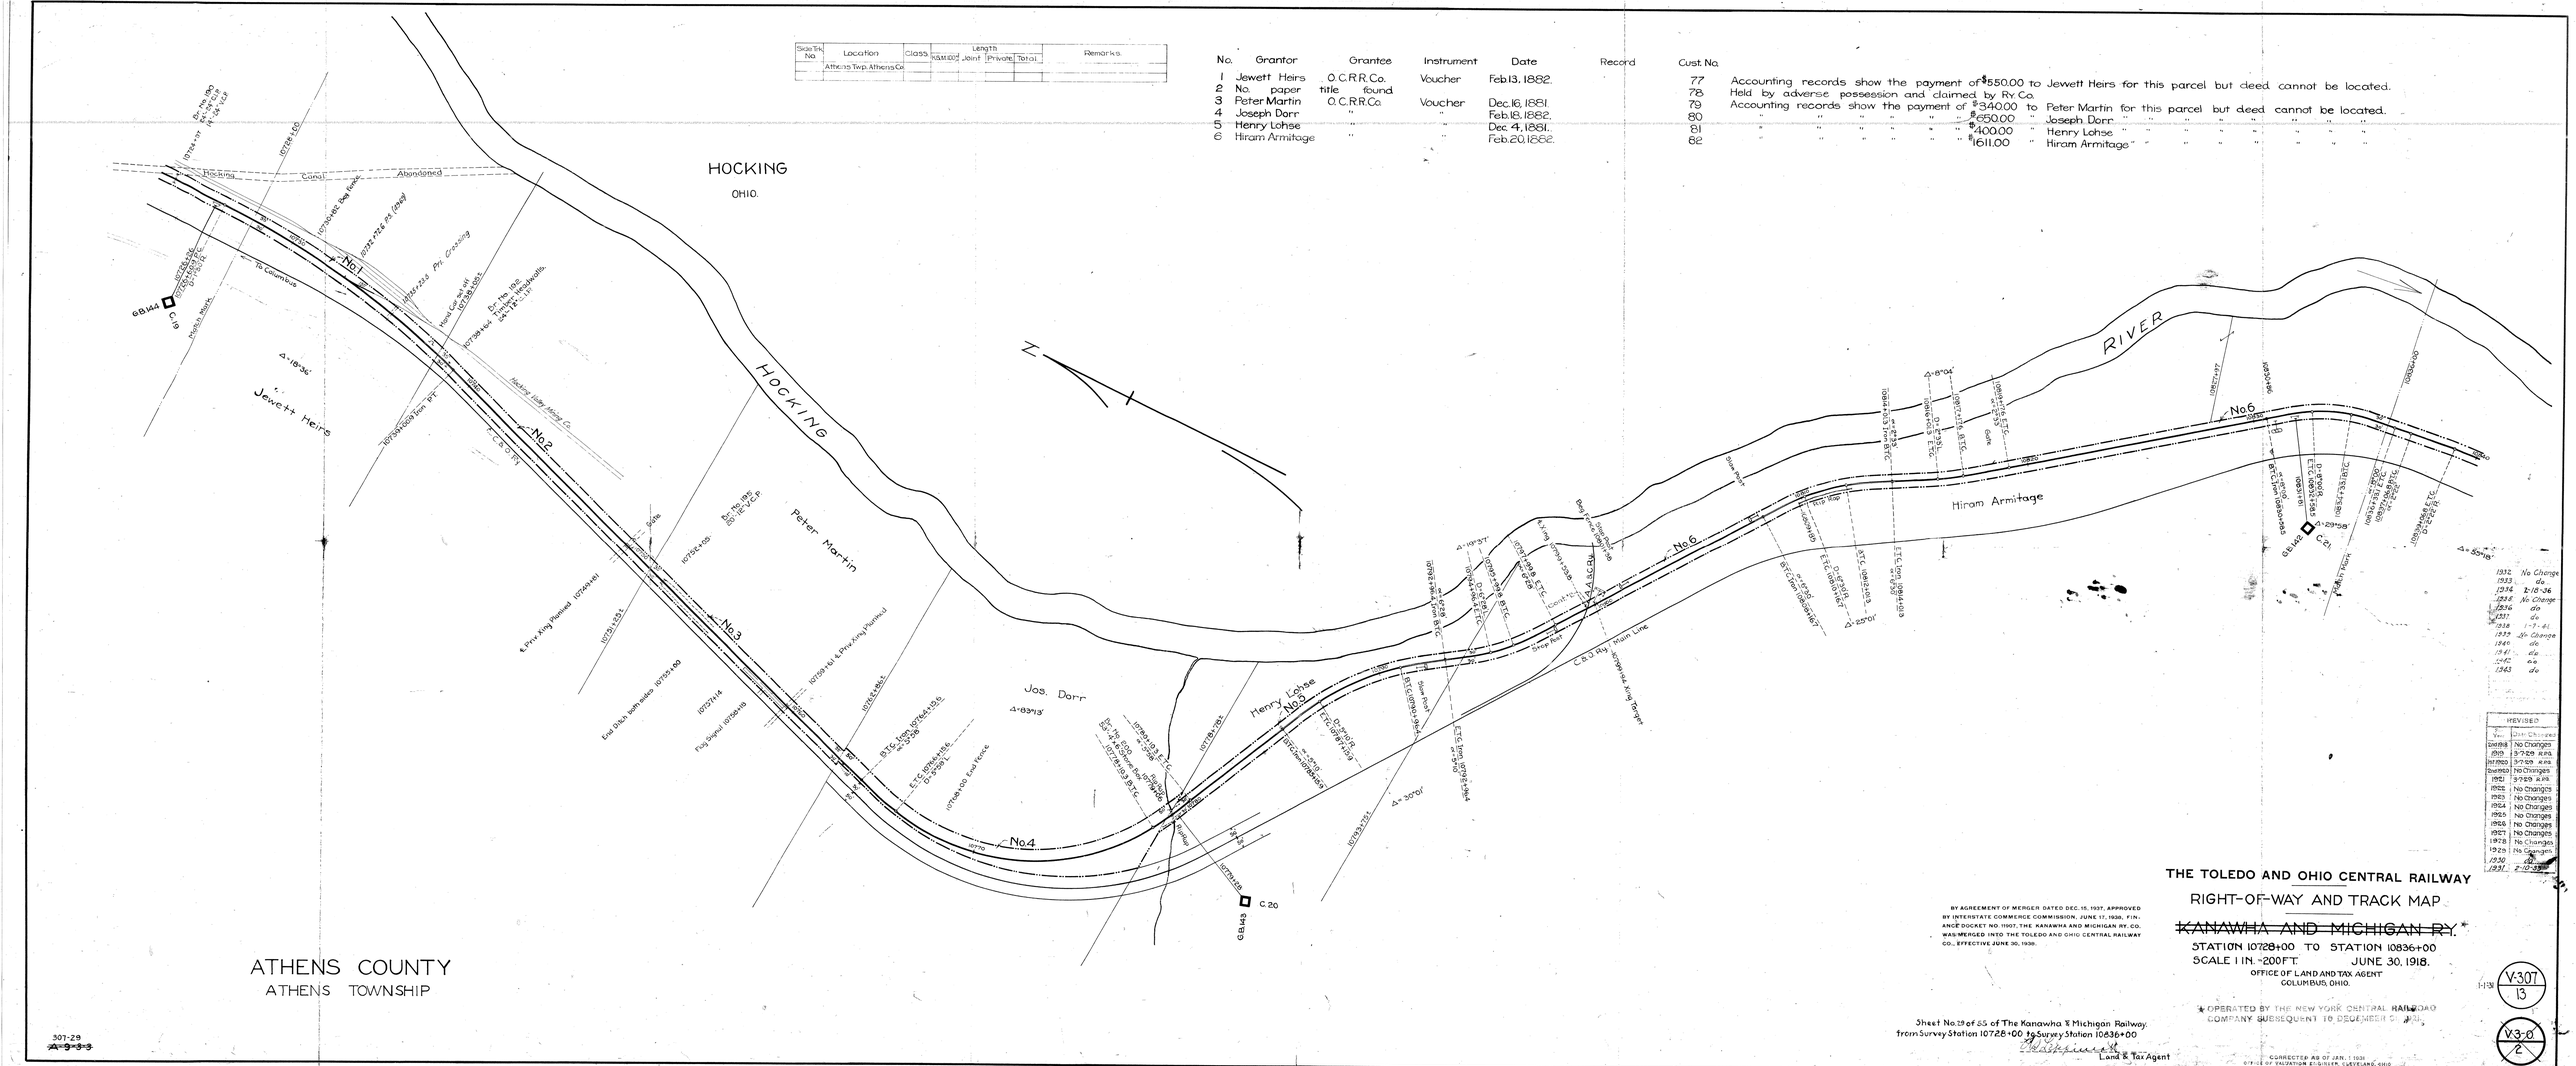

1932	No Change
1933	do
1934	2-18-36
1935	No Change
1936	do
1937	do
1938	1-7-41
1939	No Change
1940	do
1941	do
1942	do
1943	do

REVISED	
Year	Date Changed
Dec 1918	No Changes
1919	3-7-29 R.P.S.
Oct 1920	3-7-29 R.P.S.
Dec 1920	No Changes
1921	3-7-29 R.P.S.
1922	No Changes
1923	No Changes
1924	No Changes
1925	No Changes
1926	No Changes
1927	No Changes
1928	No Changes
1929	No Changes
1930	do
1931	2-10-33

ATHENS COUNTY
ATHENS TOWNSHIP

BY AGREEMENT OF MERGER DATED DEC. 15, 1937, APPROVED BY INTERSTATE COMMERCE COMMISSION, JUNE 17, 1938, FINANCE DOCKET NO. 11907, THE KANAWHA AND MICHIGAN RY. CO. WAS MERGED INTO THE TOLEDO AND OHIO CENTRAL RAILWAY CO., EFFECTIVE JUNE 30, 1938.

THE TOLEDO AND OHIO CENTRAL RAILWAY

RIGHT-OF-WAY AND TRACK MAP

~~KANAWHA AND MICHIGAN RY.~~ *

STATION 10728+00 TO STATION 10836+00
SCALE 1 IN. = 200 FT. JUNE 30, 1918.
OFFICE OF LAND AND TAX AGENT
COLUMBUS, OHIO.

* OPERATED BY THE NEW YORK CENTRAL RAILROAD COMPANY SUBSEQUENT TO DECEMBER 31, 1921.

Sheet No. 29 of 55 of The Kanawha & Michigan Railway, from Survey Station 10728+00 to Survey Station 10836+00

Land & Tax Agent

CORRECTED AS OF JAN. 1, 1931
OFFICE OF VALUATION ENGINEER, CLEVELAND, OHIO

V-307 / 13

V-3-0 / 2

307-29
~~A-9-3-3~~