Plat of a survey of a part of Out Lot 10 Albany

DISCRIPTION

Beginning at a point in the North line of Clinton street 19.5 feet S 85¼° W from the south west corner of in lot number 278 in Albany: Thence N 4¼° E 132 ft. to the north west corner of said in lot, thence S 85¼° W 17ft. to (I.P.); Thence N 55° W 71 ft to the corner (I.P.); Thence S 3½° E 122.7' to corner (I.P.); North west city lot; Thence S 84¼° E 50ft. to North East corner of City Lot (I.P); Thence S 8° W 76.6' to (I.P.) North line of Clinton Street; Thence N 85¼° E 75.7' to place of begining.

Surveyed August 23, 1934 for M.D. Hughs
Executor of the estate of Alla Stanley
E.G. Biddison
Dep. Co. Surveyor

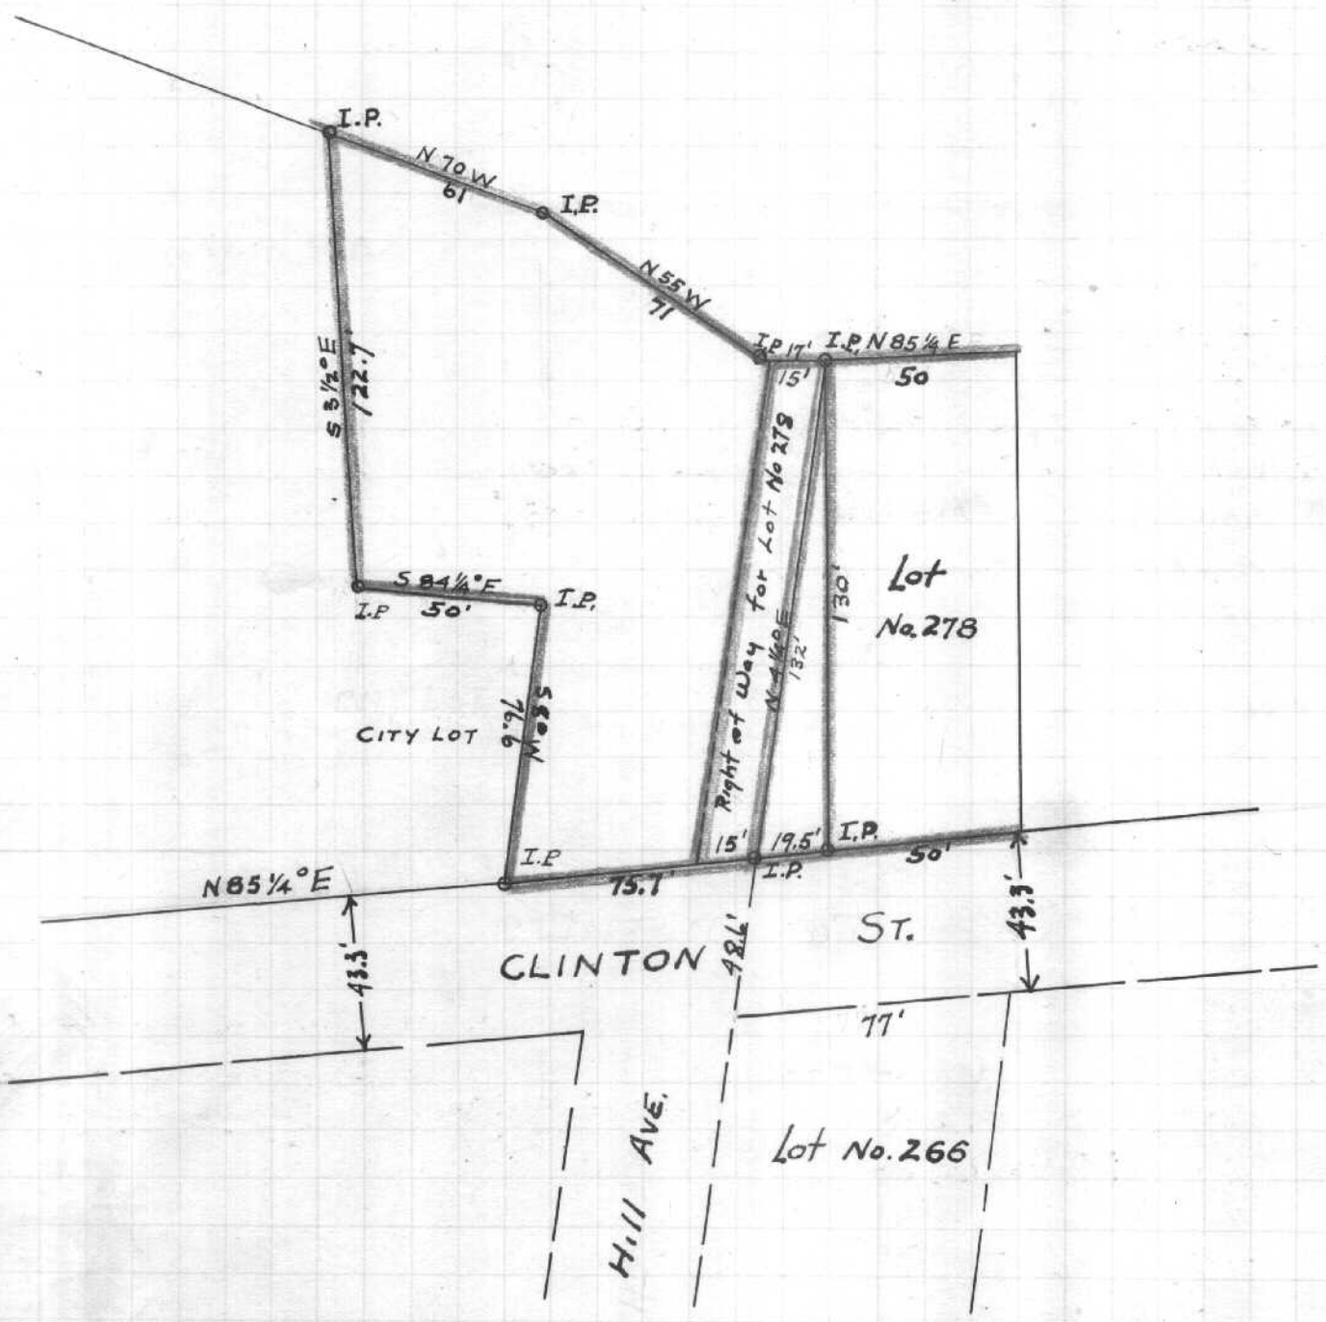
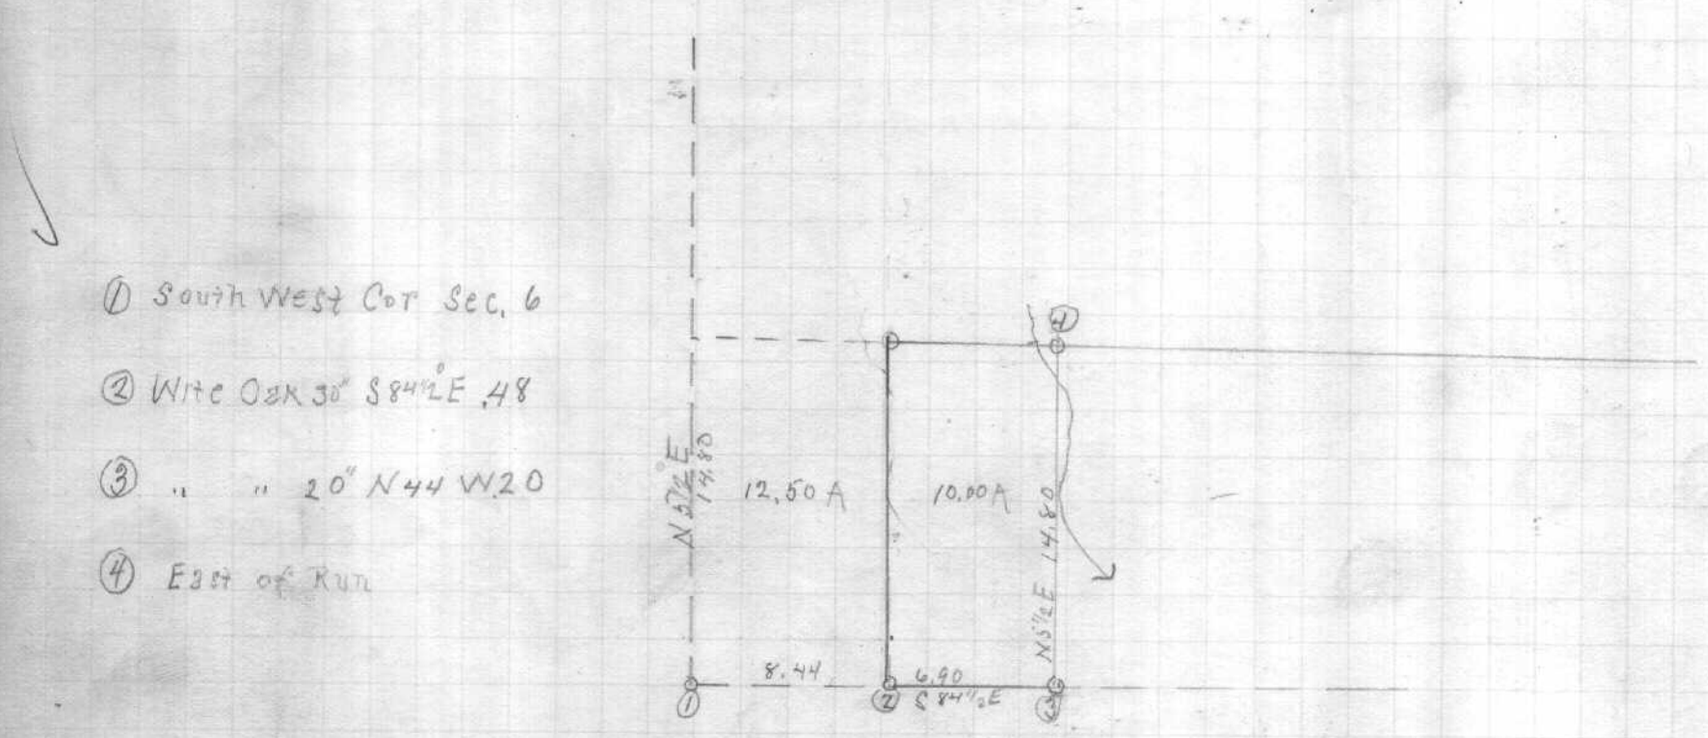
Survey of a 10 A Lot off west end Catherin Kinnen Farm in S. 4. T4. R. 13. Lodi Twp.
Surveyed for Mike Kinnen January 16 1935 E. G. Biddison, Dep. Surveyor