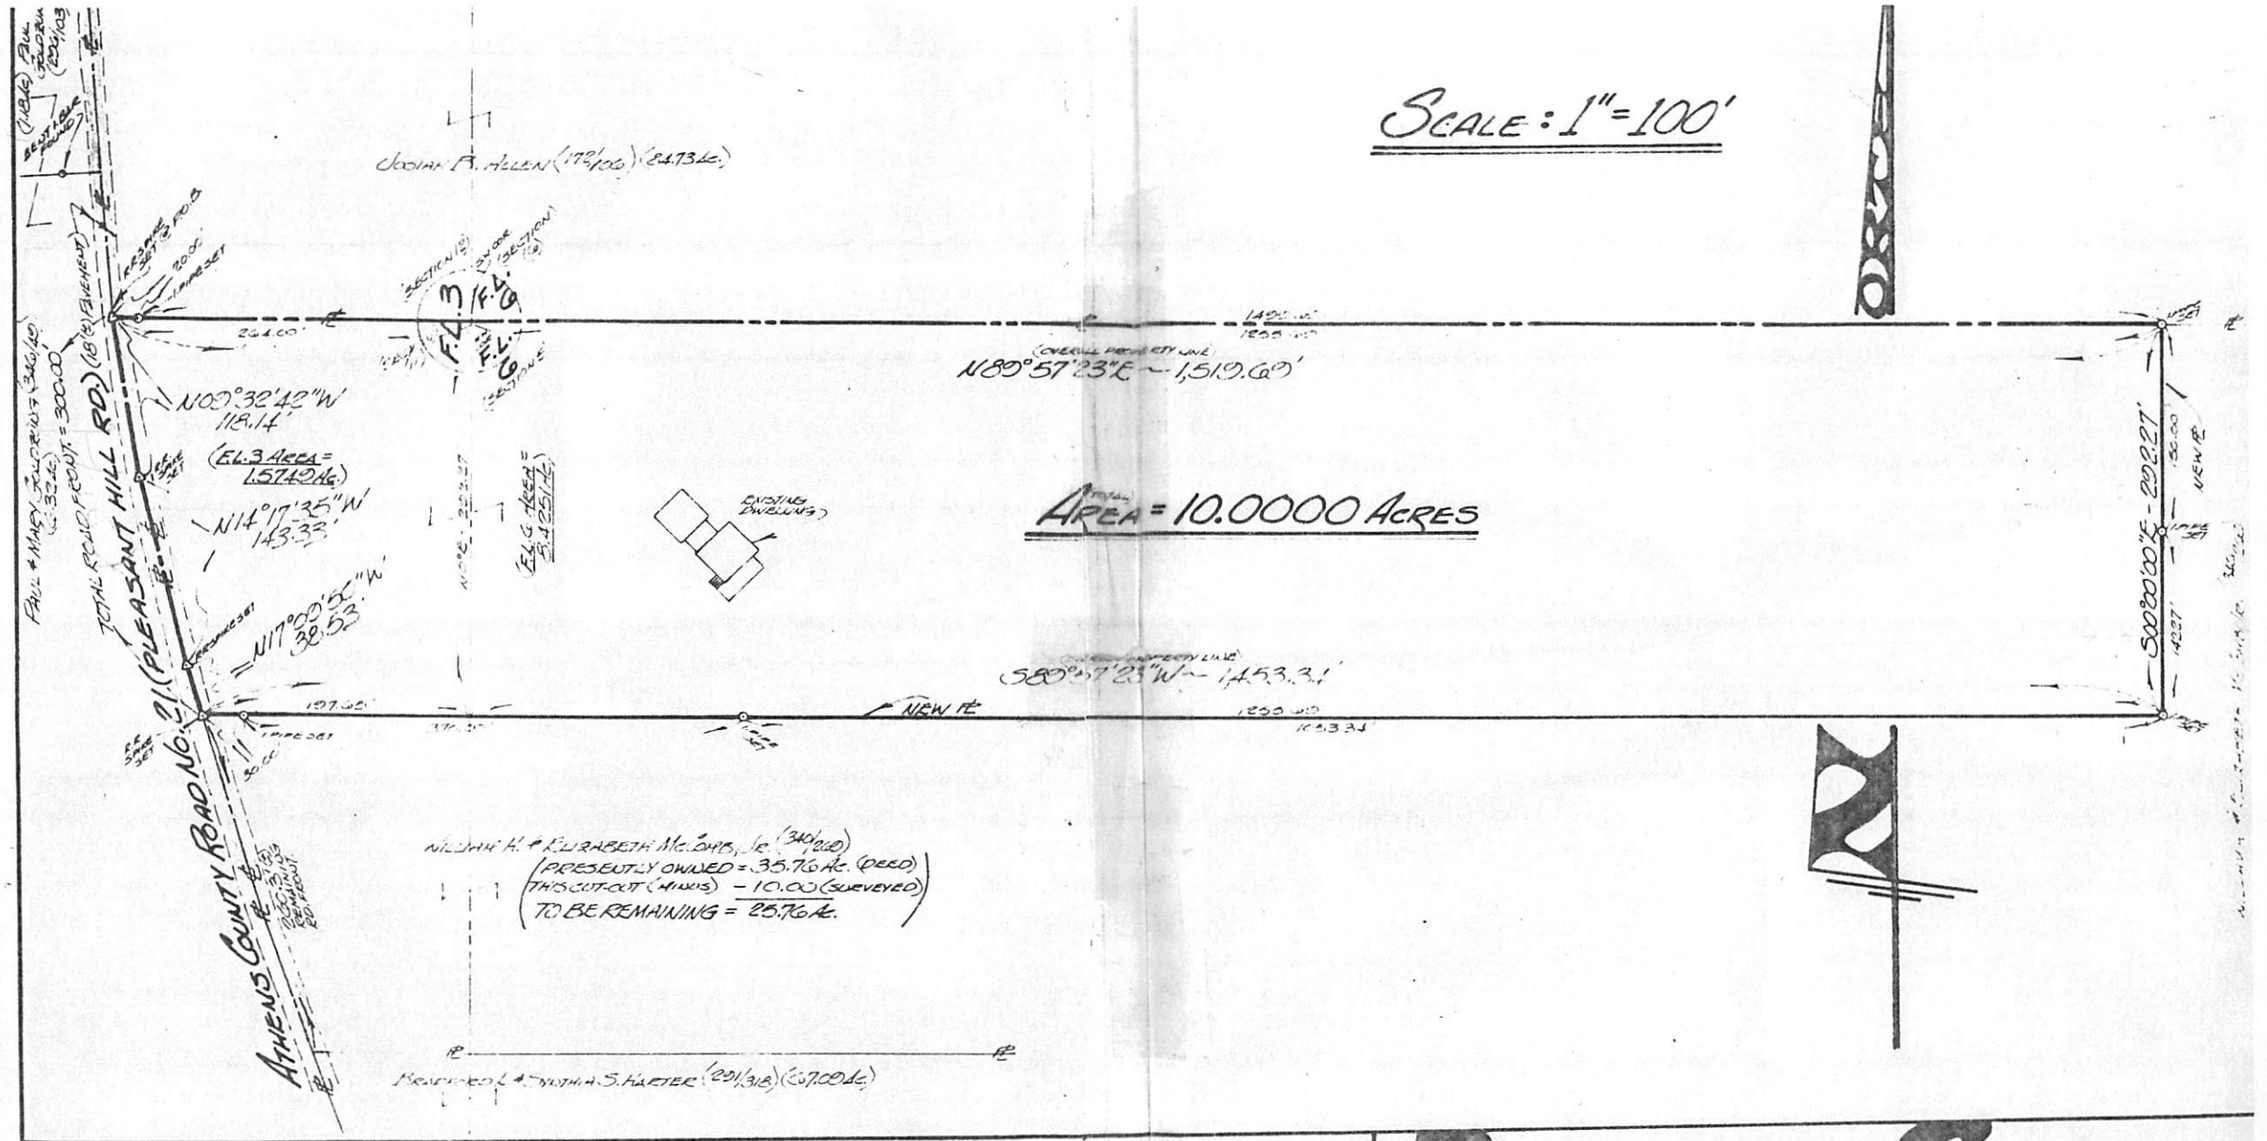

FOR:

WILLIAM McCOMB (JR.)
ROUTE 5 ~ BOX NO. 221-B
ATHENS, OHIO 45701

BY:

GERALD W. BAYHA, P.S.
REGISTERED PROFESSIONAL SURVEYOR NO. S-6130
ROUTE NO. 5 ~ BOX NO. 204
(PLEASANT HILL) ATHENS, OHIO 45701 ~ (614) 592-4328

Gerald W. Bayha P.S.

PLAT OF SURVEY

OF A 10.0000 ACRE TRACT SITUATE IN F.L. 3 (SECTION 11) & F.L. 6 (SECTION 5) ~ TOWN 8 ~ RANGE 14 ~ ALEXANDER TOWNSHIP ~ ATHENS COUNTY ~ OHIO ~ U.S.A.

DRAWN	CHECKED	REVISIONS	DATE	JOB NO.
GB	GB		9 MAY 1978	#478-13

1/1
SHEET NO.