


REFERENCES
 DEEDS AS SHOWN
 TAX PLATS
 PREVIOUS SURVEY BY LEONARD F. SWOYER, JR. 07-04-98
 PREVIOUS SURVEY BY GERALD W. BAYHA 07-29-85

ASSUMED MERIDIAN RELATIVE TO THE EAST LINE OF GRANTOR'S PROPERTY AS ESTABLISHED BY FOUND MONUMENTS.

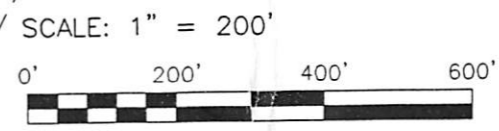

- LEGEND
- STONE FOUND
 - 5/8" IRON PIN SET, CAPPED SCRIBED L. F. SWOYER PS 6765

Description checked for Mathematical Accuracy
 ATHENS COUNTY ENGINEER'S OFFICE
 BY: S. Blausen
 DATE: 4-3-03

"Approved by the Athens County Regional Planning Commission; No Plat Required"

S. Blausen
 Planning Director
 Tracts 1, 2, 3

Mena T. Smith
 315-915
 92.44 Acres

4-22-03
 Date

OK to transfer TRACTS 1 and 3 only Check Home P.S.

OK TO TRANSFER Michael Cooper, SGT 4-18-03

LINE	BEARING	DISTANCE
L1	N 55°44'56" W	48.75'
L2	N 74°30'30" W	122.76'
L3	N 67°06'19" W	38.55'

SOUTHEASTERN LAND SURVEYS
 3428 PLEASANT HILL ROAD
 ATHENS, OHIO 45701
 (740) 593-8701

PLAT OF SURVEY OF TRACTS 1 THROUGH 3, INCLUSIVE, SITUATED IN LEASE LOT 3, SECTION 9 AND LEASE LOT 4, SECTION 10, ALEXANDER TOWNSHIP, TOWN 8, RANGE 14, ATHENS COUNTY, OHIO

PREPARED BY: SOUTHEASTERN LAND SURVEYS
 FOR: DAVID SMITH * 10-16-01 * REV. 04-02-03

Leonard F. Swoyer, Jr.
 LEONARD F. SWOYER, JR.
 REGISTERED PROFESSIONAL LAND SURVEYOR No. 6765




Alex-9 NE
31.988 Ac.
6.290 Ac.