

ALEXANDER LOCAL SCHOOL DISTRICT 41.50 AC. 262-439

S 89°58'16"E

RICKARD 32.09 AC. 211-179

N.W. COR OF
L.L. #2


S 89°58'16"E

1012.97'

958.28'

ROBERT AND SUSAN
GRINSTEAD
246-862
25.57 ACRES

N

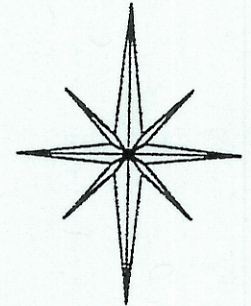

TRACT "A"
25.18 ACRES

TRACT "B"
25.18 ACRES

LEE TWP. SEC. 3
ALEXANDER TWP SEC. 33

N 0°03'33"E

982.05'

S 0°00'00"W

1003.98'

SCALE 1 INCH = 200 FEET

- = IRON PIN FOUND
- △ = IRON PIN SET 5/8" X 30" REBAR
- = MINE BOLT SET

12/21/01
 OK to transfer per Athens City Co. Health Dept.
 "existing single family dwelling, with new sewage system,
 off lot discharge easements required for discharge from
 tract "C" to tract "A" and tract "B"

Chel C. Hammer R.S.

N 88°58'30"E
431.93'

260.34'

S 89°46'08"W 368.88'

S 0°11'07"W
165.24'

TRACT C
0.662 AC.
N 0°42'17"W
168.48'

S 0°13'17"W
150.00'

MORRISON
160-709

AMES
310-257

+17.31' 580.72' +152.87' 174.17' +15.71' 848.07' L.L.#2

N 89°56'52"W

COUNTY ROAD 70

L.L.#3

Description checked for
Mathematical Accuracy
ATHENS COUNTY
ENGINEER'S OFFICE

BY: S. Blauson
DATE: 12-21-01

SURVEY OF THREE TRACTS
IN F.L. #2, SECTION 33,
T.8, R.14, ALEXANDER TOWNSHIP
ATHENS COUNTY, OHIO
SURVEYED DECEMBER 2001

"Approved by the Athens
County Regional Planning
Commission; No plat
Required"

Planning Director Date 12-28-2001

BY: JOHN M. BRANNER P.S. 6805
12500 N. PEACH RIDGE ROAD
ATHENS, OHIO 45701
(740) 592-5778