

PROJECT NO. 08-0910

PREPARED FOR
CRAIG KINZELMAN

STATE OF OHIO
ATHENS COUNTY
ALEXANDER TOWNSHIP
TOWNSHIP 8 RANGE 14
SECTION 1

LEGEND


5/8" CAPPED REBAR SET
5/8" CAPPED REBAR FOUND
STONE FOUND

REFERENCE

LODI TAX MAP 31
ALEXANDER TAX MAP 1
DEEDS AS LISTED
SURVEY FLAT
ROBERT A. PRICE FEB. 2007

Description Checked for
Mathematical Accuracy
Athens County
ENGINEER'S OFFICE

BY: S. Blouder
DATE: 10-15-08

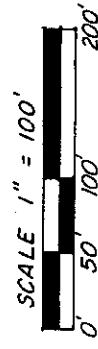

CHARLES F. HUGHES, JR.

PROFESSIONAL SURVEYOR

P.O. BOX 216, MINERAL WELLS, WV 26150

1-304-489-9640

DATE ASSIGNED: _____ DWN BY: _____ FIELD CONTROL: _____

DATE COMPLETED: _____ DWN BY: _____ SCALE: 1" = 100'

BASIS OF BEARINGS
SURVEY FLAT
ROBERT A. PRICE PS 8362

CRAIG KINZELMAN
384-279
367-3
81.48 AC.

BARRY BOBO
367-1037
334-423
69.15 AC.


KEITH BOLIN
340-375
340-371
15.25 AC.

MICHAEL CARBAUGH
234-140
12-25
42.25 AC.

CRAIG KINZELMAN
186-629
114.50 AC.

WOODYARD ROAD
0.9794 ACRES

11/3/08
OK. to transfer 0.9794 acres
Not a building tract. MUST
be held contiguous and continuous
with adjacent 14.5 ac. tract
W.C. Young R.S.
OK TO TRANSFER - DEED SHALL
STATE 0.9794 AC. IS TO BE CONTIGUOUS
CONTIGUOUS WITH
O.R. 186-629 Sub Side Plat 8 1/31 TWP 4
10-7-2008 11-4-08 TWP 7 6 36 TWP 3

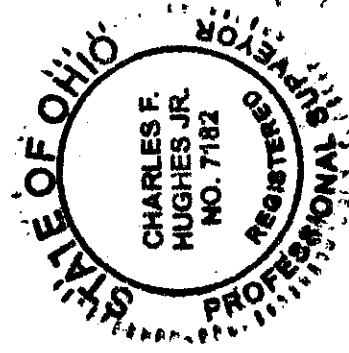

Charles F. Hughes, Jr.

CHARLES F. HUGHES, JR. PS 7182

DATE