


FRANK NADROSKI
V-213 - P. 38
13.65 A.

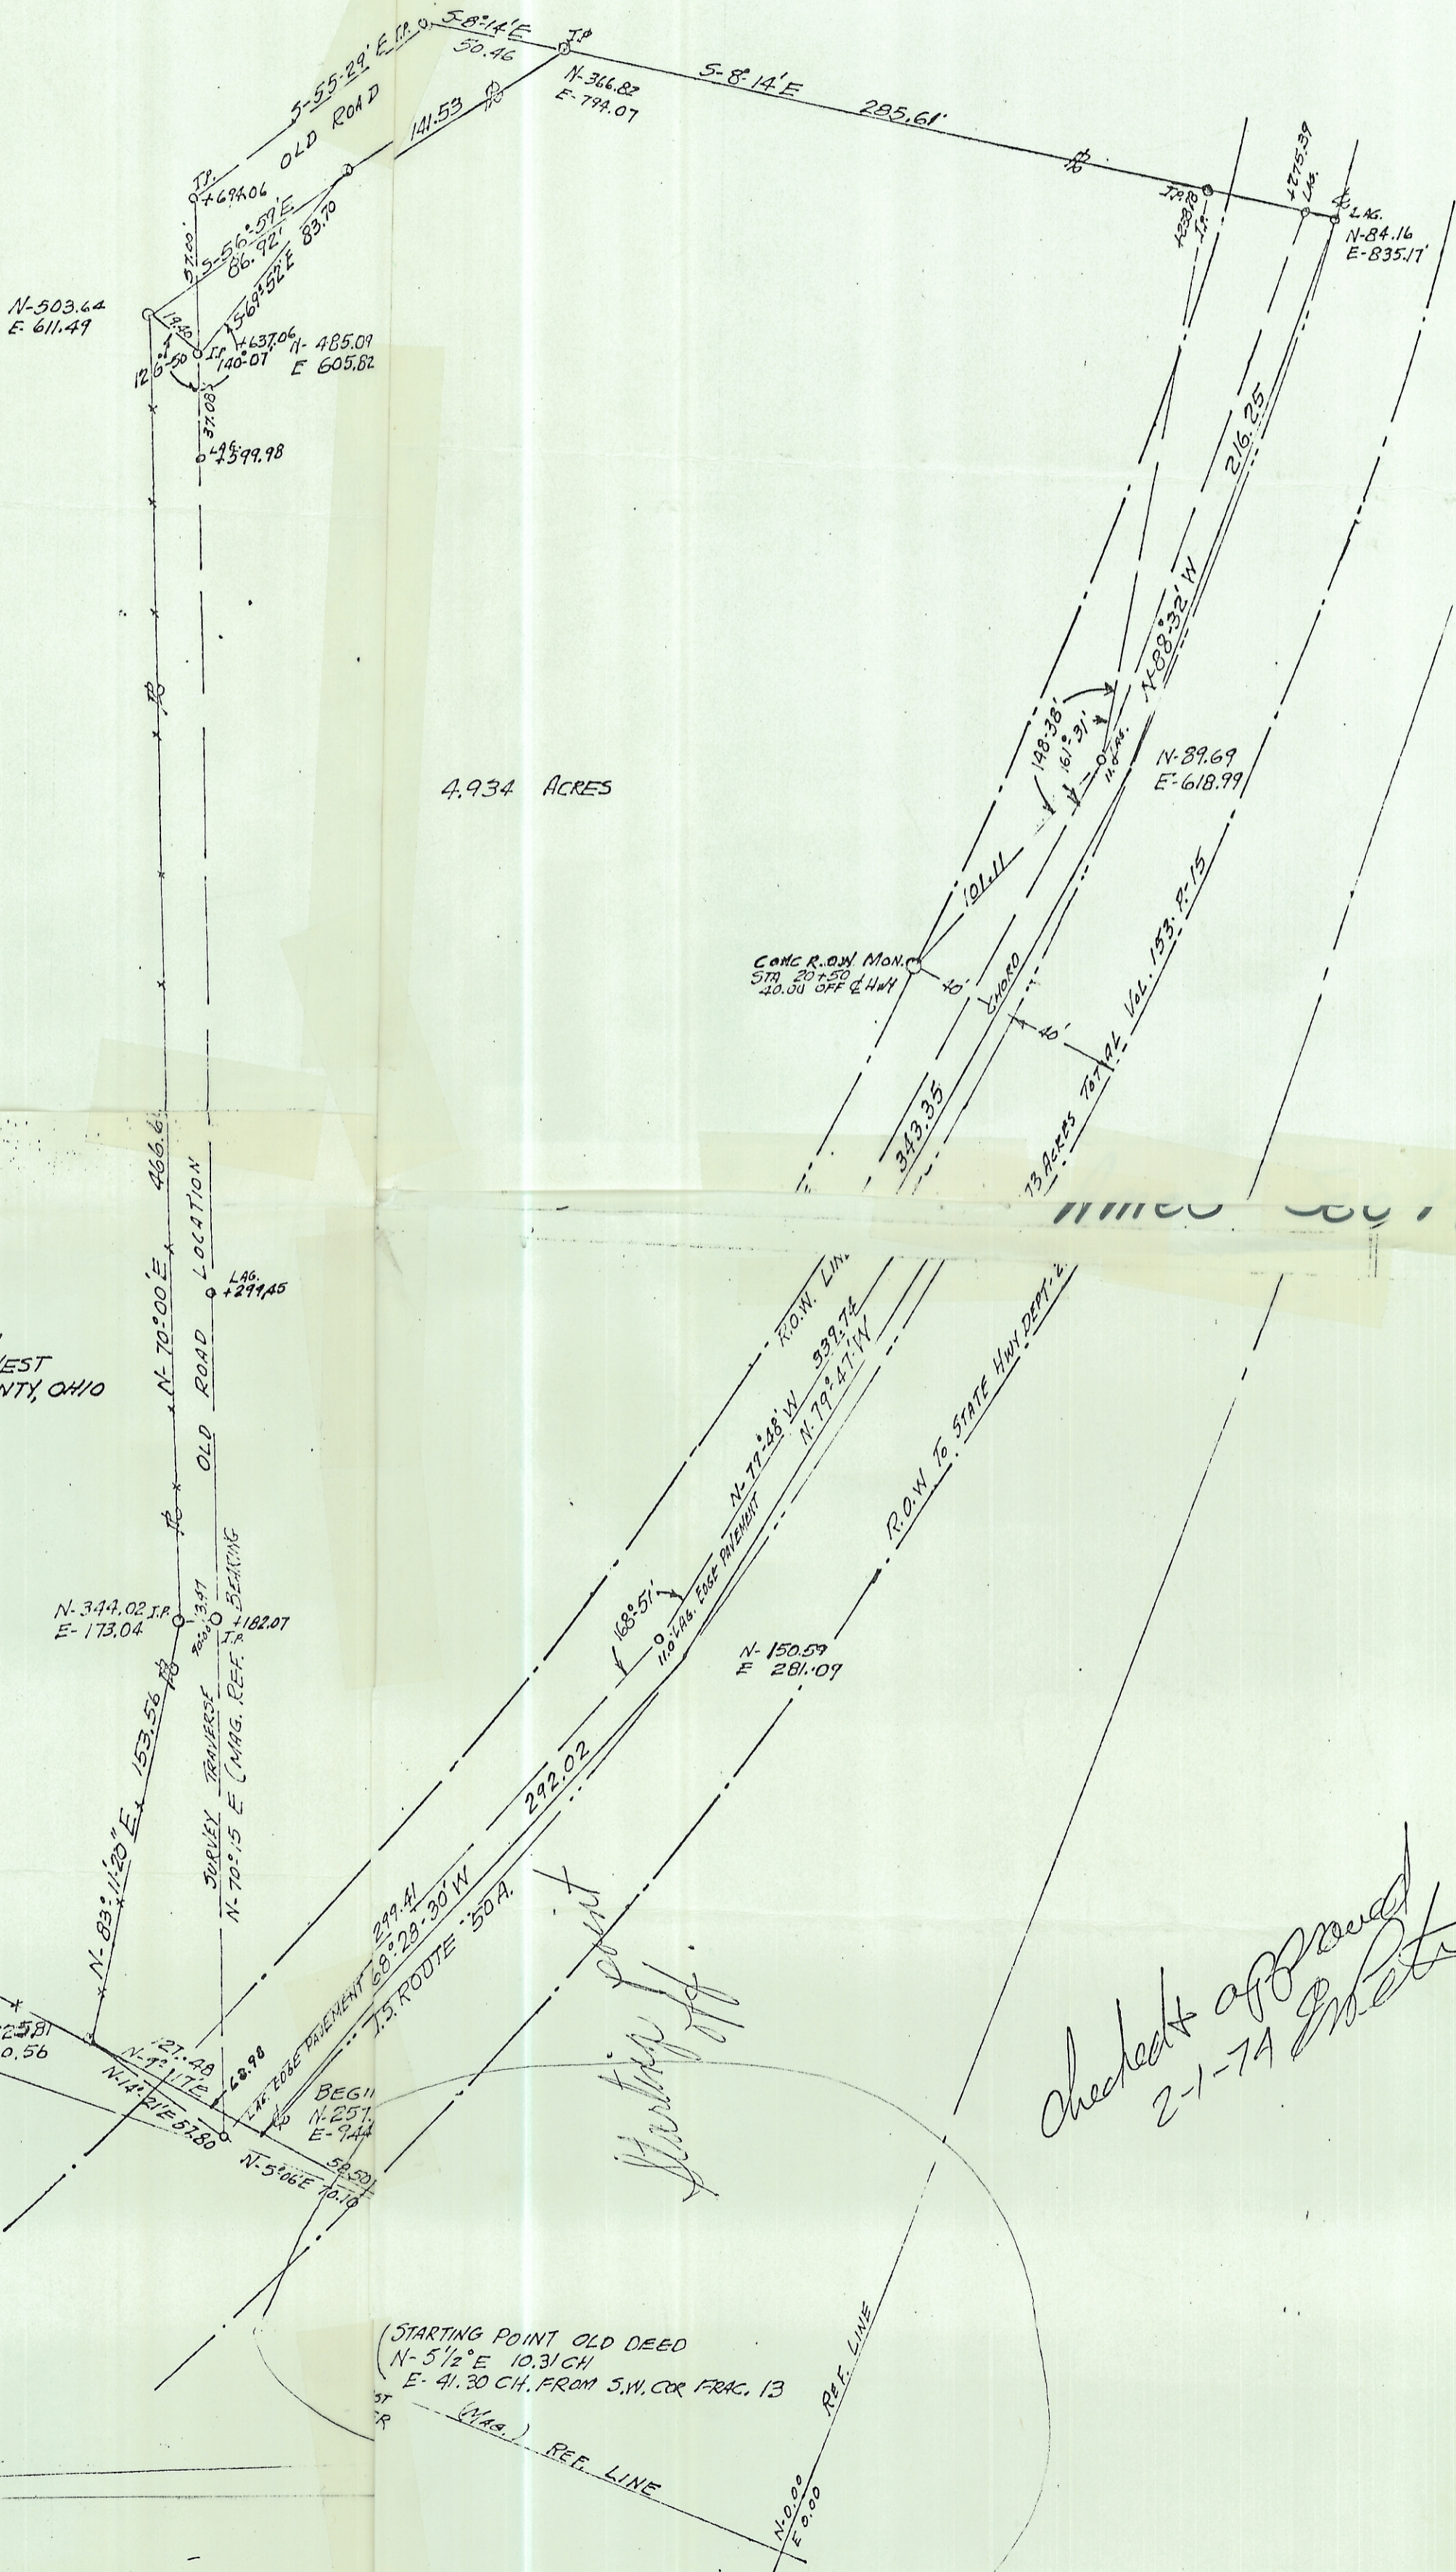

4.934 ACRES

SURVEY OF 4.934 ACRES OWNED BY FRANK NADROSKI
SITUATED IN FRAG. 13 SEC. 14, TOWN. 6 NORTH, RANGE 13 WEST
OHIO COMPANY'S PURCHASE, AXLES TOWNSHIP, ATHENS COUNTY, OHIO
SOLD TO ROSILEA KRAHEL & HUSBAND
SURVEYED BY F.A. DIXON REG. ENGR 9786
JAN. 30, 1974 SURV. 3060
SCALE 1" = 50'

Checked approved
2-1-74 [Signature]

AMES 14
A93AAC
SE

(STARTING POINT OLD DEED
N-5 1/2° E 10.31 CH
E-41.20 CH. FROM S.W. COR FRAG. 13
(Mag.) REF. LINE

SURV
4114
DIO
SOLD
SURV