





ROBINSON SURVEYING

12355 Liars Corner Rd.
Millfield, Ohio 45761
(740) 593-8774



OK to transfer 5.056 acres. "House, water & sewer layout details are not approved until the proper permits are obtained from the health department"

Charles C. Hammer R.S.
August 25, 2000

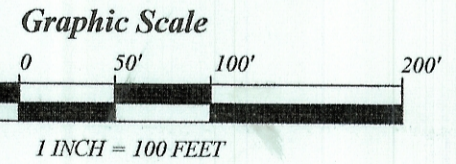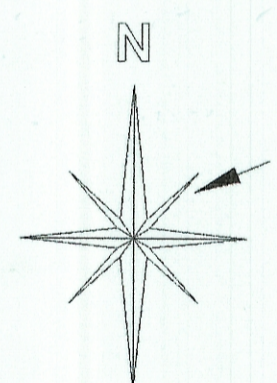

BUYER: TODD WOLFE:
 DATE: 8/14/00
 ADDRESS: , AMESVILLE, OH
 SECTION 17, AMES TOWNSHIP,
 ATHENS COUNTY, OHIO
 SURVEY MADE FOR AND AT THE INSTANCE OF:
 MEADOWS FINANCIAL QUEST, INC. AND FOR

NOTE: THIS SURVEY IS FOR MORTGAGE PURPOSES ONLY AND NO PROPERTY STAKES WERE SET. DO NOT USE FOR ESTABLISHING FENCE-LINES OR BUILDING LINES
 MORTGAGE LOCATION SURVEY CHAPTER 4733-38 O.A.C.

BY: Alan D. Robinson
 ALAN D. ROBINSON P.S. 8049, 12355 LIARS CORNER ROAD,
 MILLFIELD, OHIO 45761 (740) 593-8774

