CARPENTER PLACE PARKING

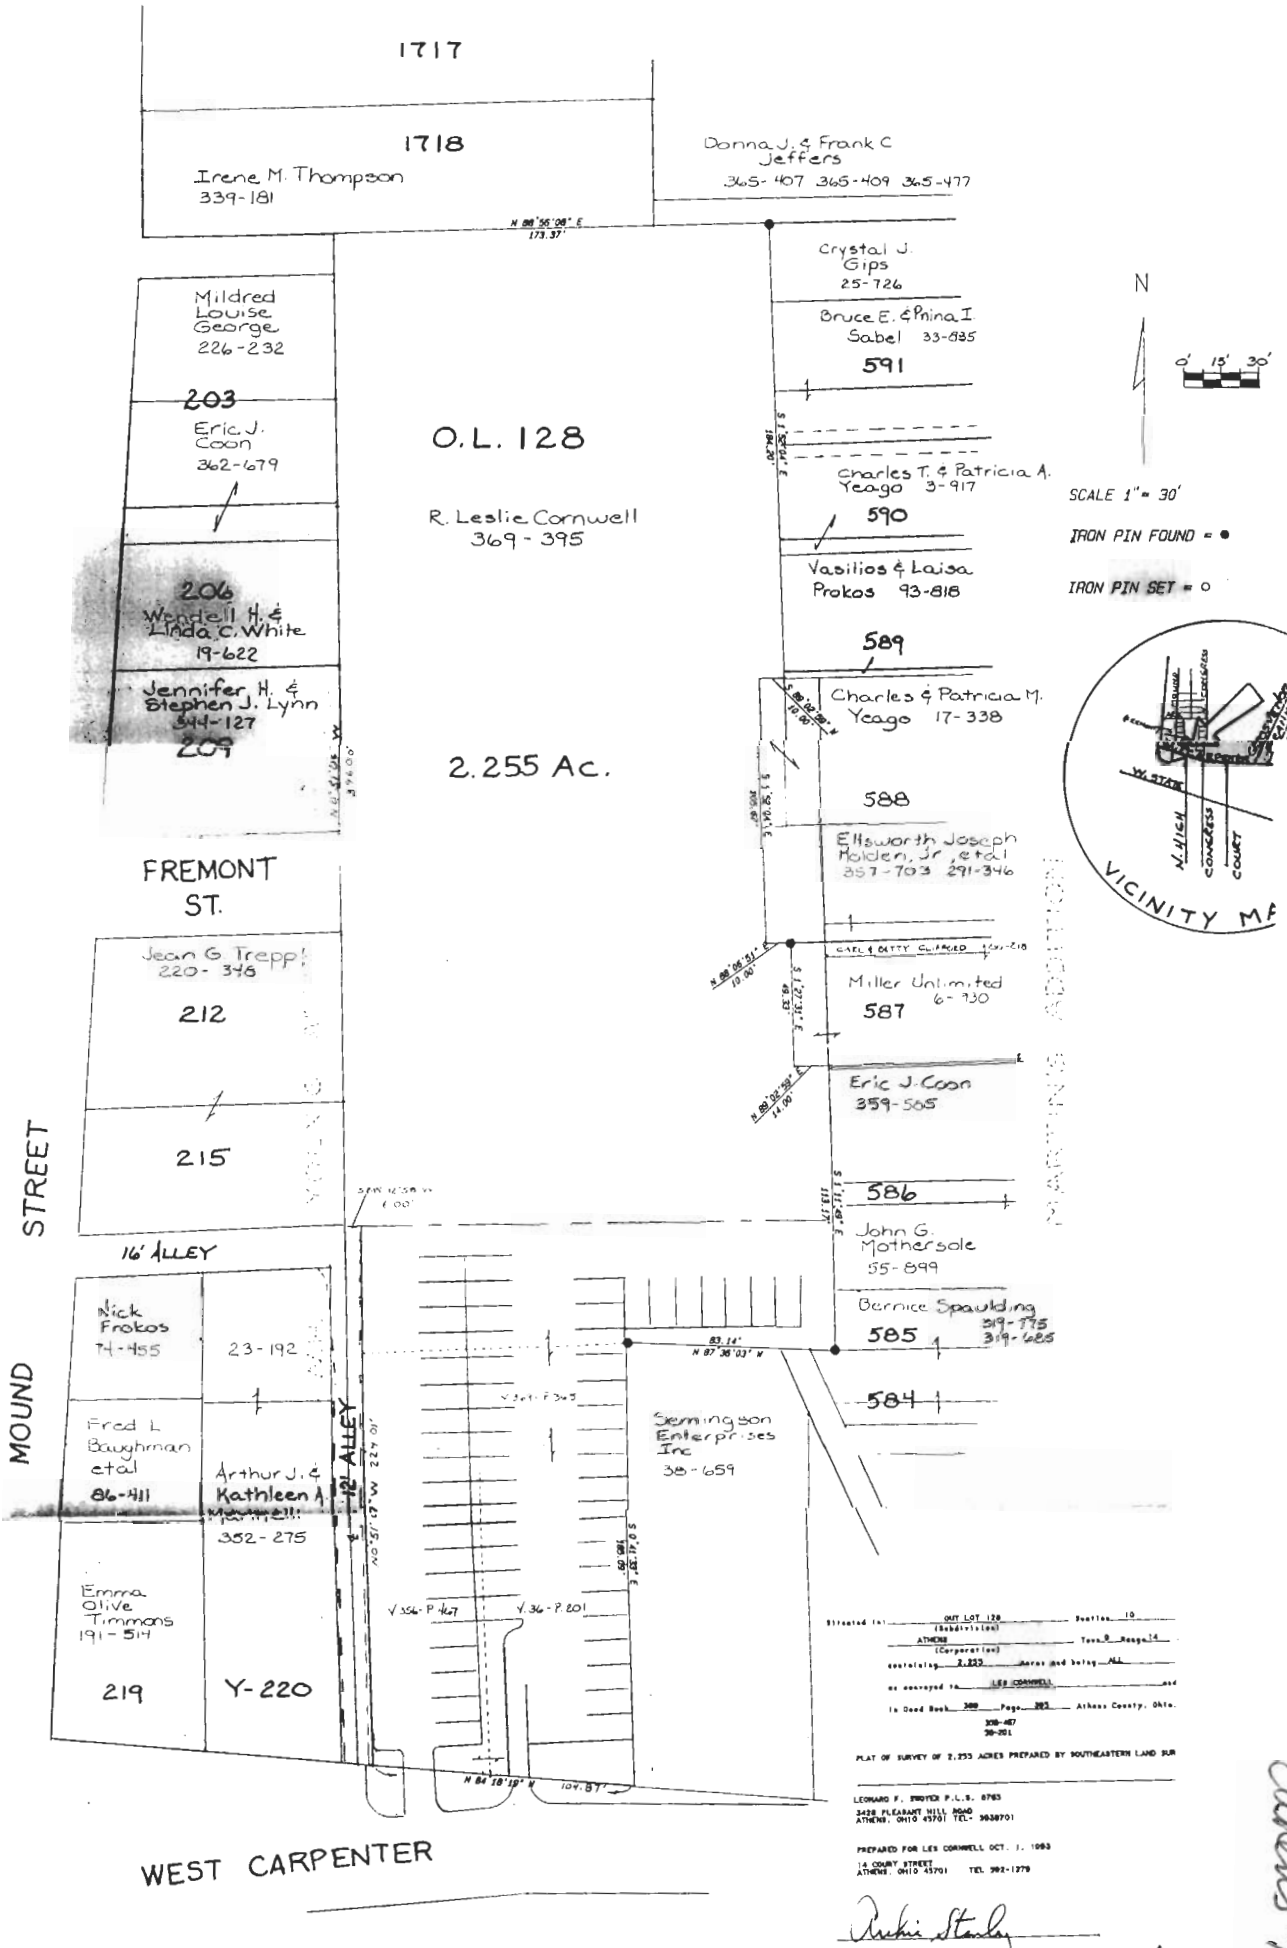

Situated in ORT LOT 128 Section 10
(Subdivision)
ATHENS Town 9 Range 14
(Corporation)
containing 2.255 Acres and being ALL
as conveyed to LES CORNWELL and
in Deed Book 369 Page 395 Athens County, Ohio.
308-467
38-201

PLAT OF SURVEY OF 2.255 ACRES PREPARED BY SOUTHEASTERN LAND SUR

LEONARD F. SNYDER P.L.S. 8783
3428 PLEASANT HILL ROAD
ATHENS, OHIO 45701 TEL. 9630701

PREPARED FOR LES CORNWELL OCT. 1, 1983

14 COURT STREET
ATHENS, OHIO 45701 TEL 592-1279

Ruckie Stanley

ATHENS COUNTY ENGINEER

APPROVED THIS 1st DAY OF

Approved this day of 19 Pres.

Approved this day of 19

City

_____, owner(s) of the land platted hereto do(es) hereby certify that the plat as shown hereon is a correct SUBDIVISION of Lot(s) ___ to ___ inclusive only, reserving ___ and dedicate to public use as such all or parts of the streets, alleys, parks, planting strips etc. shown hereon and not heretofore dedicated. The undersigned further agree that any use of improvements made on this land shall be in conformity with all existing laws and regulations including the applicable off-st. planting, health, or lawful rules and regulations of Athens County, Ohio for the benefit of themselves and all abutting lots and land lawfully using water from under, or through the undersigned.

WITNESS

OWNER

WITNESS

OWNER

Public in and for said County, personally came ___ severally and ___ voluntary act and deed for the uses

Athens #10

99