

French Ervin
247-287
4957 Ac.

Basharat M. Mirza
335-95


Glenna M. Ball
187-474 & 224-190
25.10 Ac.

James & Aaron
Swearington
366-277
1.45 Ac.

Basharat M. Mirza
335-95

State of
Ohio
359-909

State of Ohio
359-913
30' Easement
(0.085 Ac.)

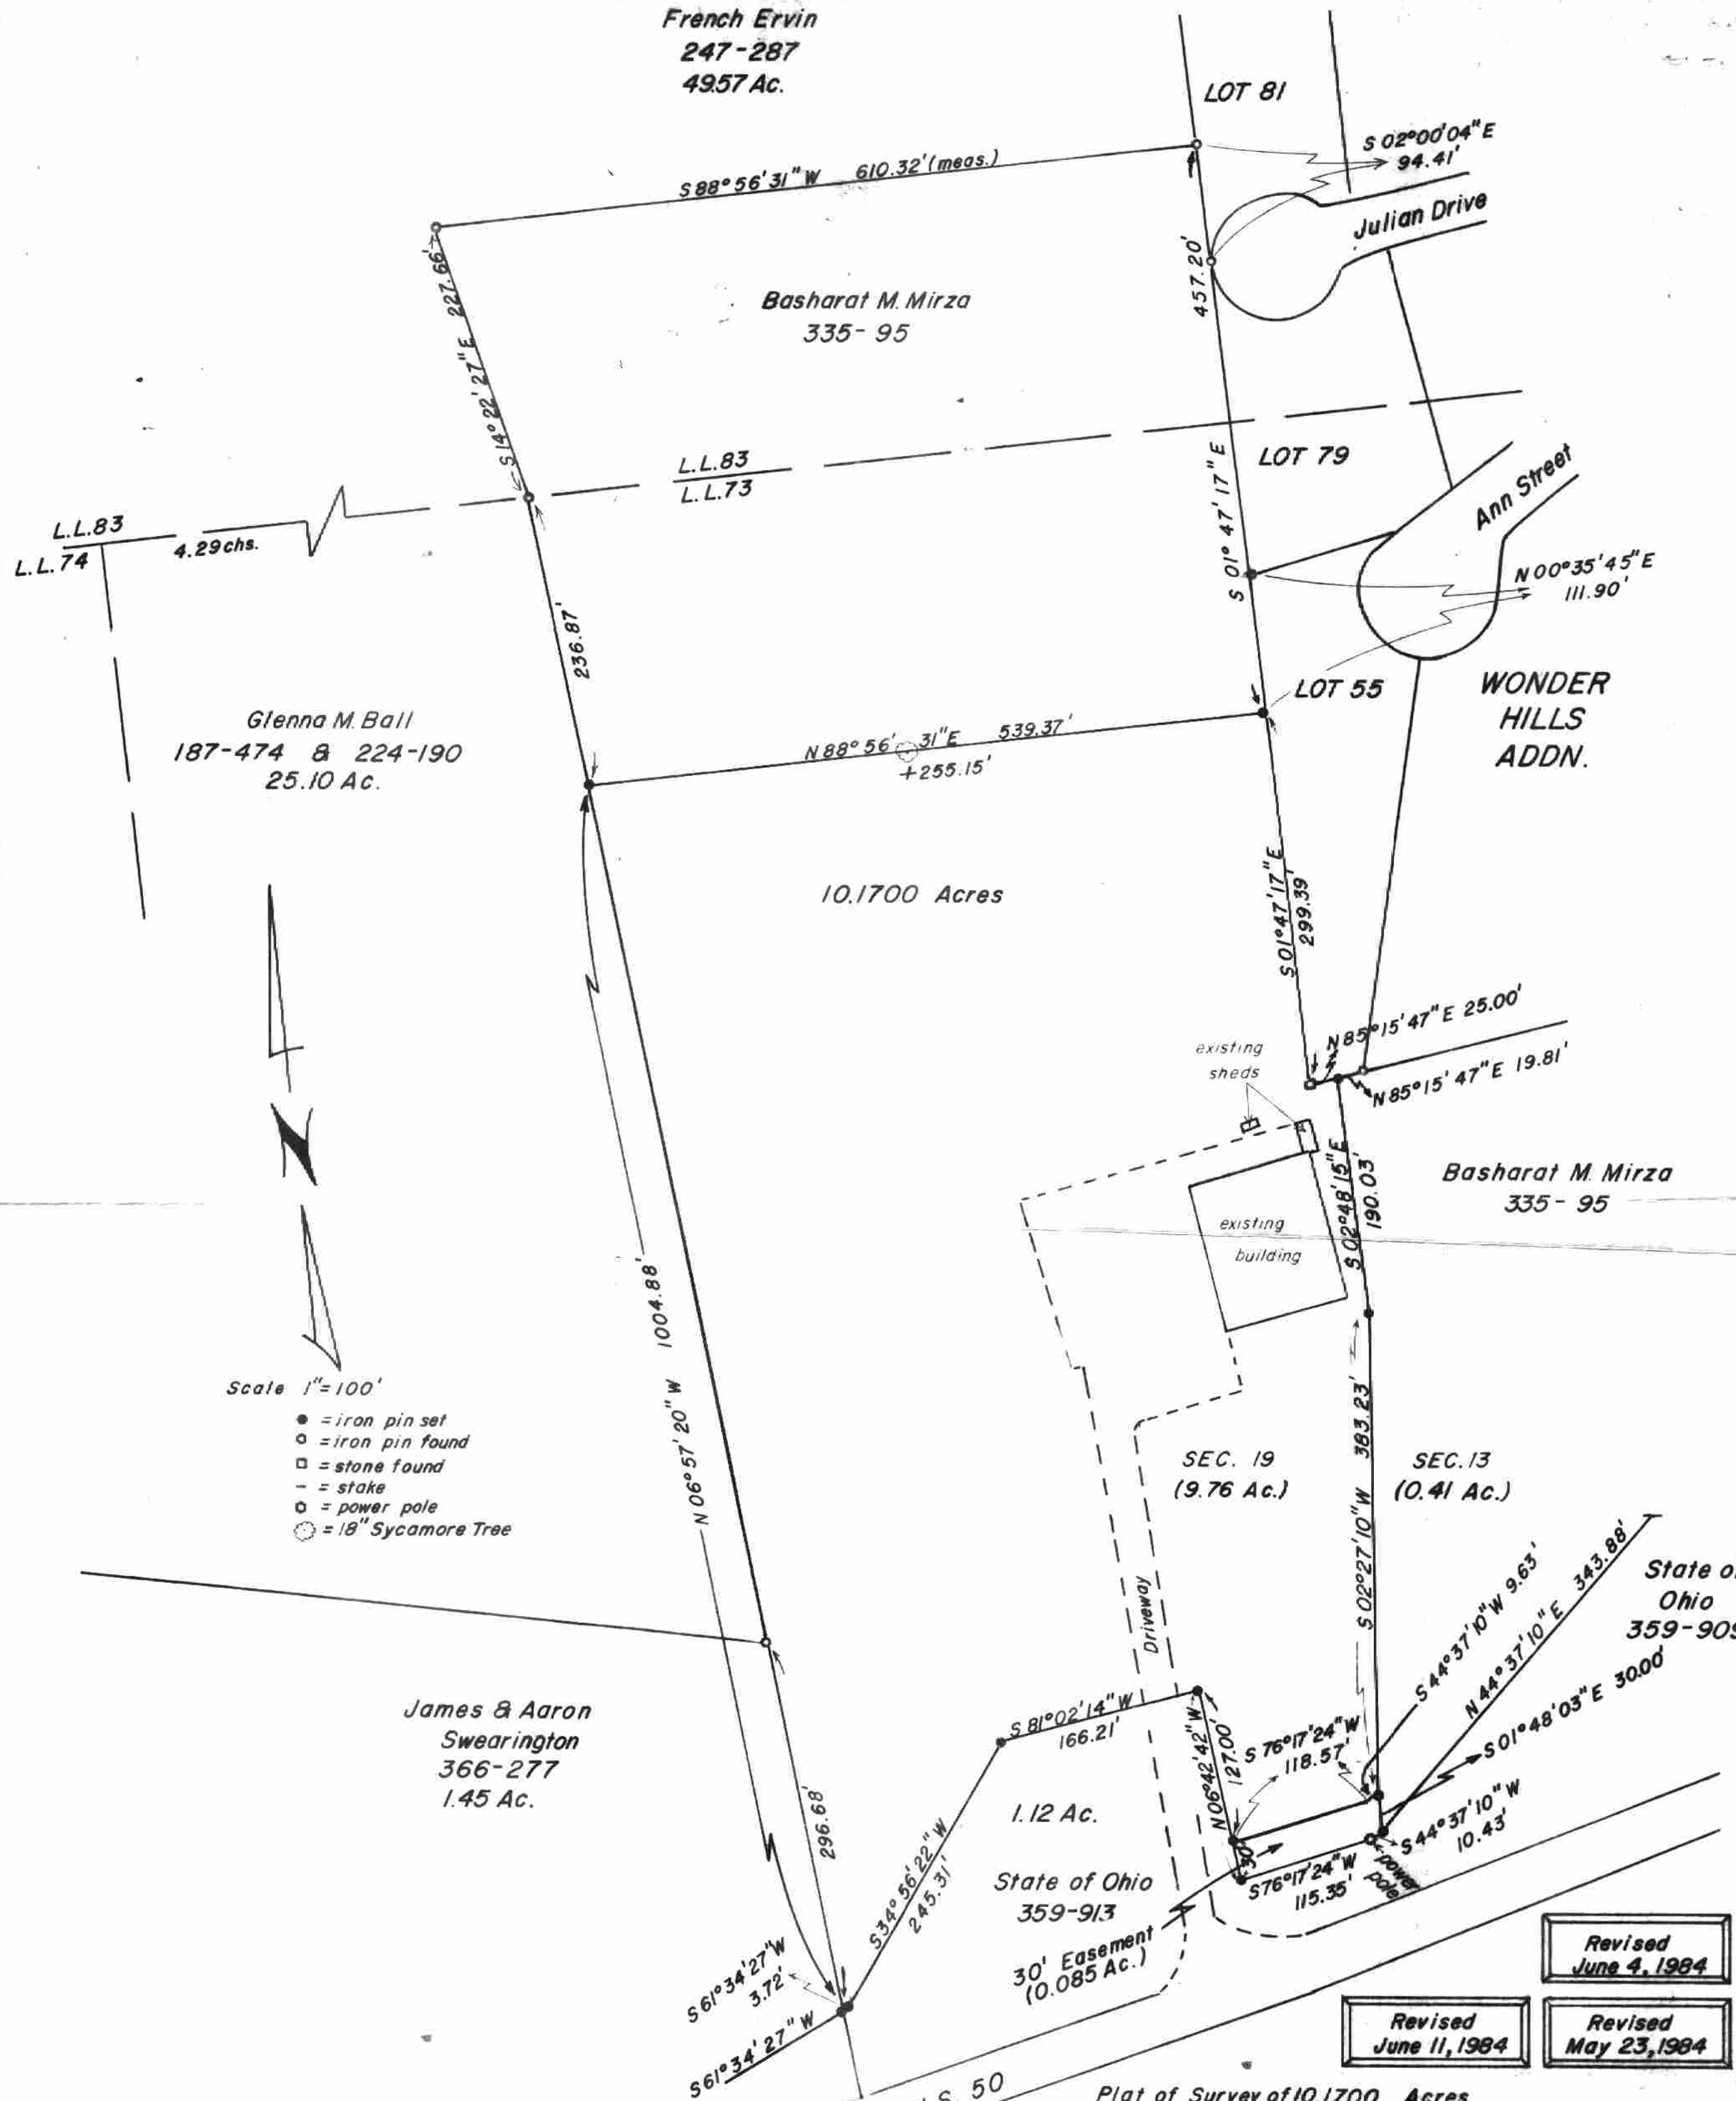

- Scale 1"=100'
- = iron pin set
 - = iron pin found
 - = stone found
 - = stake
 - ⊙ = power pole
 - ⊙ = 18" Sycamore Tree

Revised June 4, 1984
Revised June 11, 1984
Revised May 23, 1984

Plat of Survey of 10.1700 Acres
Located in Lease Lot 73, Sec. 19 & Sec. 13,
Athens Township, Athens County, Ohio.

Prepared by

SOUTHEASTERN SURVEYS
For: B. Mirza May 10, 1984
Leonard F. Swayer II
Leonard F. Swayer II Reg. Surv. No. 6765

I certify that the above plat
is a correct representation
of all improvements and that
all dimensions are correct.