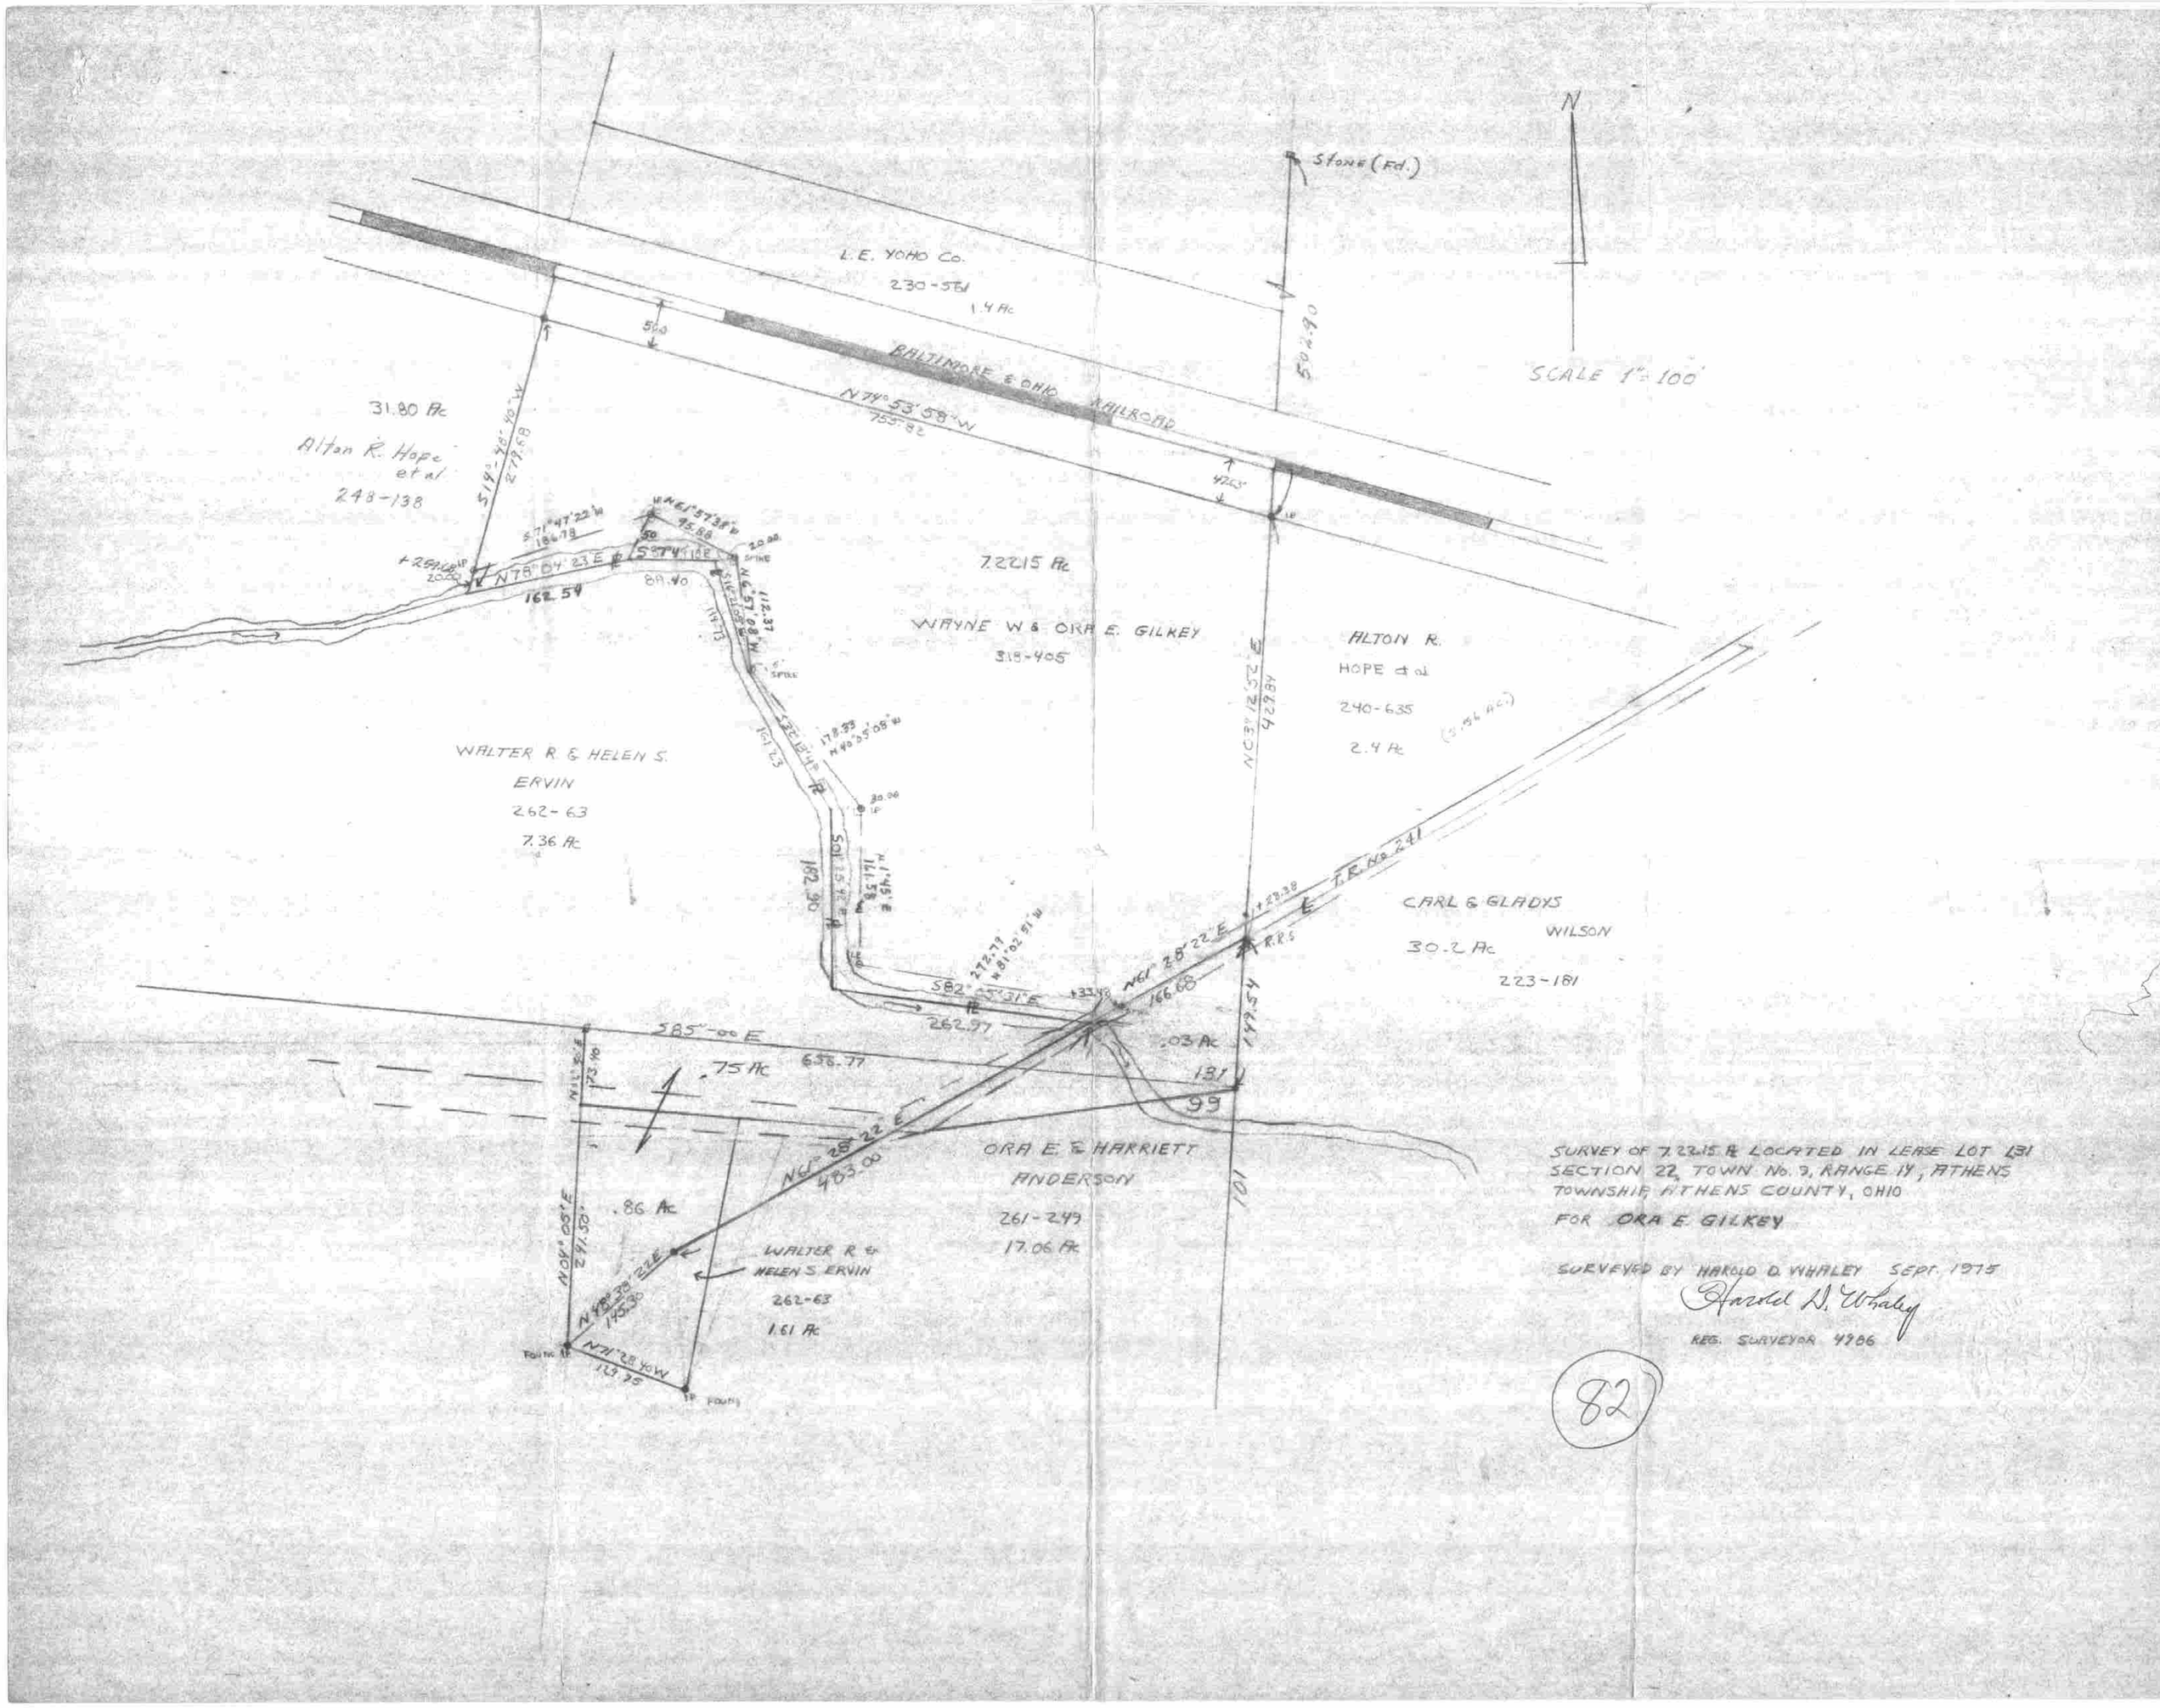

SURVEY OF 7.2215 Ac LOCATED IN LEASE LOT L31
SECTION 22, TOWN No. 9, RANGE 14, ATHENS
TOWNSHIP, ATHENS COUNTY, OHIO
FOR ORA E. GILKEY

SURVEYED BY HAROLD D. WHALEY SEPT. 1975

Harold D. Whaley

REG. SURVEYOR 4986

82