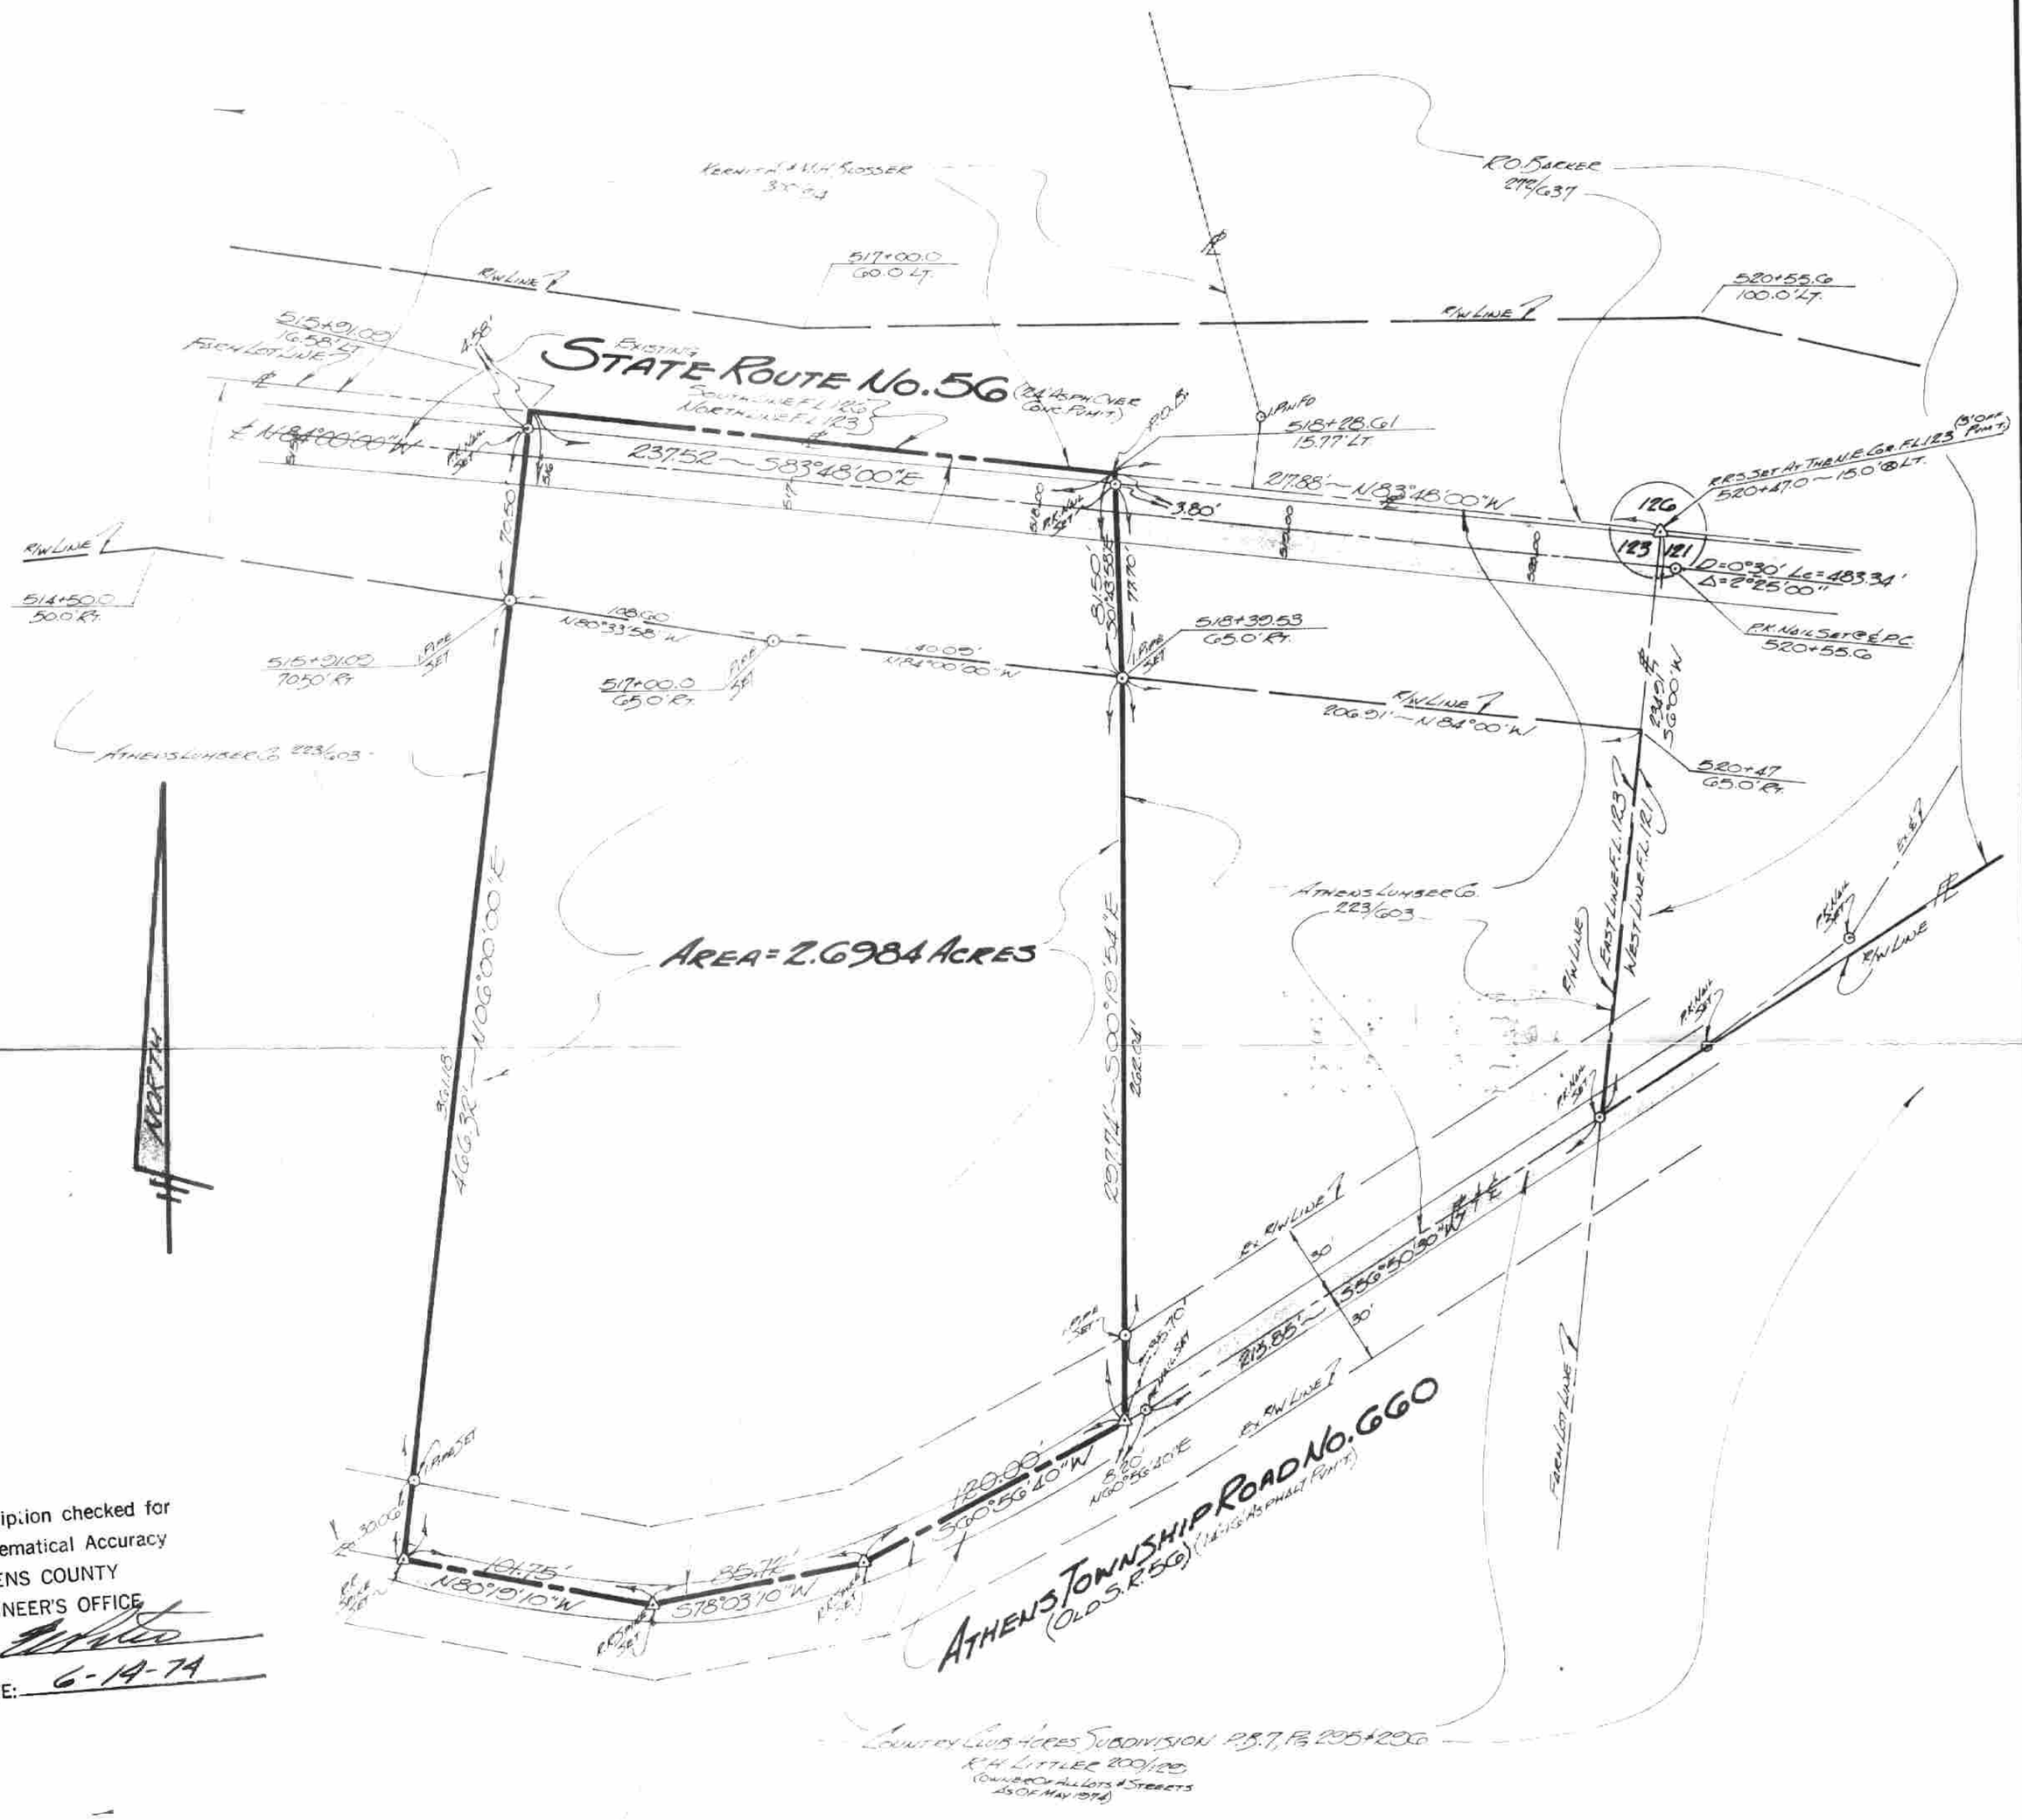

Description checked for
Mathematical Accuracy
ATHENS COUNTY
ENGINEER'S OFFICE
BY:
DATE: 6-19-74

FOR:
LEWIS ROBERTS
216 Madison Ave.
Athens, Ohio 45701

PLAT OF SURVEY

A 2± Acre Parcel Situate In Farm Lot 123, Section 26, Town 9, Range 14, Athens Township, Athens County, Ohio.

BY:
GERALD E. HANN, R.S.
21 Elmwood Place
Athens, Ohio 45701
Reg. Surveyor No. S-5062

Scale	1"=50'
Date	13 June '74
Revisions	
Drawn	GB
Checked	G.H.
Job No.	674-02

Gerald E Hann