

HIGHLAND SURVEYING
80 FAYETTE STREET
NELSONVILLE OHIO 45764
614-753-1264

Description of a 0.842 Acre Tract

Situate in the Section 33 Athens Township, T-9,R-14, Athens County, State of Ohio and also being a part of Lot 3 of the Elmer Tom's Longview Addition and being more particularly described as follows:

Beginning at an iron pin found at the Northeast corner of Lot 3 of said Addition


thence along the East line of Lot 3 South 5°15'19"West 221.50 feet to an iron pin set

thence along the North line of Lot 2 North 84°16'23"West 156.65 feet to an iron pin set

thence leaving said line North 8°06'03"West 190.32 feet to an iron pin set on the North line of Lot 3

thence along the North line of Lot 3 North 85°21'00"East 203.65 feet to the point of beginning and containing 0.842 acres.

Subject to all Easements and Rights of Way of Record

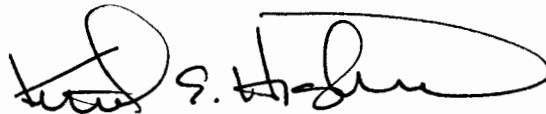

Kenneth E. Highland S-7581



Prepared for
Municipal Authority
Athens, Ohio
P.O. Box 100
Athens, Ohio
DATE: 3-20-95

S. Blauer
DATE: 3-20-95

24
ATH #33

HIGHLAND SURVEYING

REGISTERED PROFESSIONAL LAND SURVEYOR



PLAT of SURVEY OF 0.842 & 2.499 ACRE TRACTS
SURVEYED for STEPHEN CORDER
SUBDIVISION ELMER TOMS LONGVIEW ADDITION
TOWNSHIP ATHENS SECTION 33 TOWN 9 RANGE 14
CORPORATION _____ COUNTY ATHENS STATE OHIO
SCALE 1" = 100' DATE DEC 1994



KENNETH E. HIGHLAND
80 FAYETTE STREET
NELSONVILLE, OHIO 45764
614-753-1264

Kenneth E. Highland
Kenneth E. Highland S-7581

35