J-27 & 28

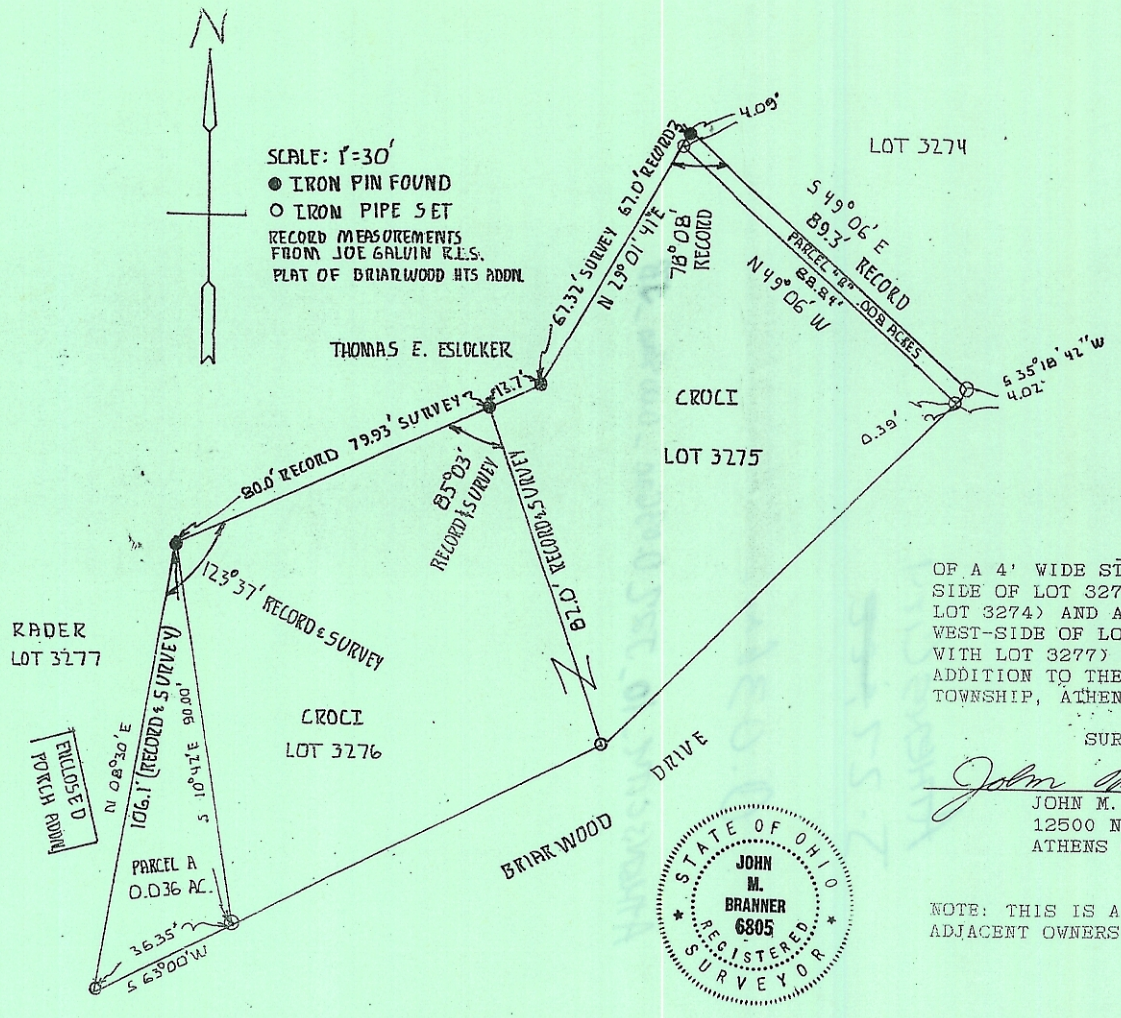


PLAT OF SURVEY

OF A 4' WIDE STRIP OFF THE NORTH-EAST SIDE OF LOT 3275 (TO BE CONTIGUOUS WITH LOT 3274) AND A TRIANGULAR STRIP OFF THE WEST-SIDE OF LOT 3276 (TO BE CONTIGUOUS WITH LOT 3277) OF BRIARWOOD HEIGHTS ADDITION TO THE CITY OF ATHENS, ATHENS TOWNSHIP, ATHENS COUNTY, OHIO

FOR DR. CROCI

SURVEYED OCTOBER 1987

John M Branner

JOHN M. BRANNER P.S. 6805
12500 N. PEACH RIDGE ROAD
ATHENS OHIO 614-592-5778

NOTE: THIS IS A TRANSFER OF LAND BETWEEN ADJACENT OWNERS