


PLAT OF SURVEY
1.2327 ACRES

LOCATED IN LEASE LOTS 45 AND 46, TOWN 9,
RANGE 14, ATHENS TOWNSHIP, CITY OF ATHENS
ATHENS COUNTY OHIO
SCALE 1" = 50' November 1, 1985
FOR ANTLE ESTATE AND JAMES SANDS

PREPARED BY

EVANS, MECHWART, HAMBLETON & TILTON, INC.
CONSULTING ENGINEERS AND SURVEYORS
GAHANNA, OHIO ATHENS, OHIO

Gregory K. Wright
Registered Surveyor #6535

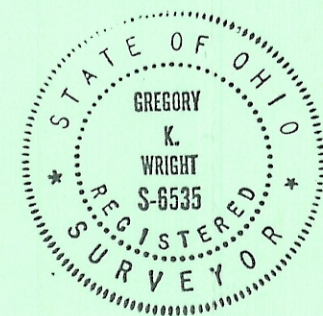

*This was not taken care of in 1985.
This does not match description and the
deed has a different description than the
map. This is not in Lease.
This is not in Lot 45?*

K 27