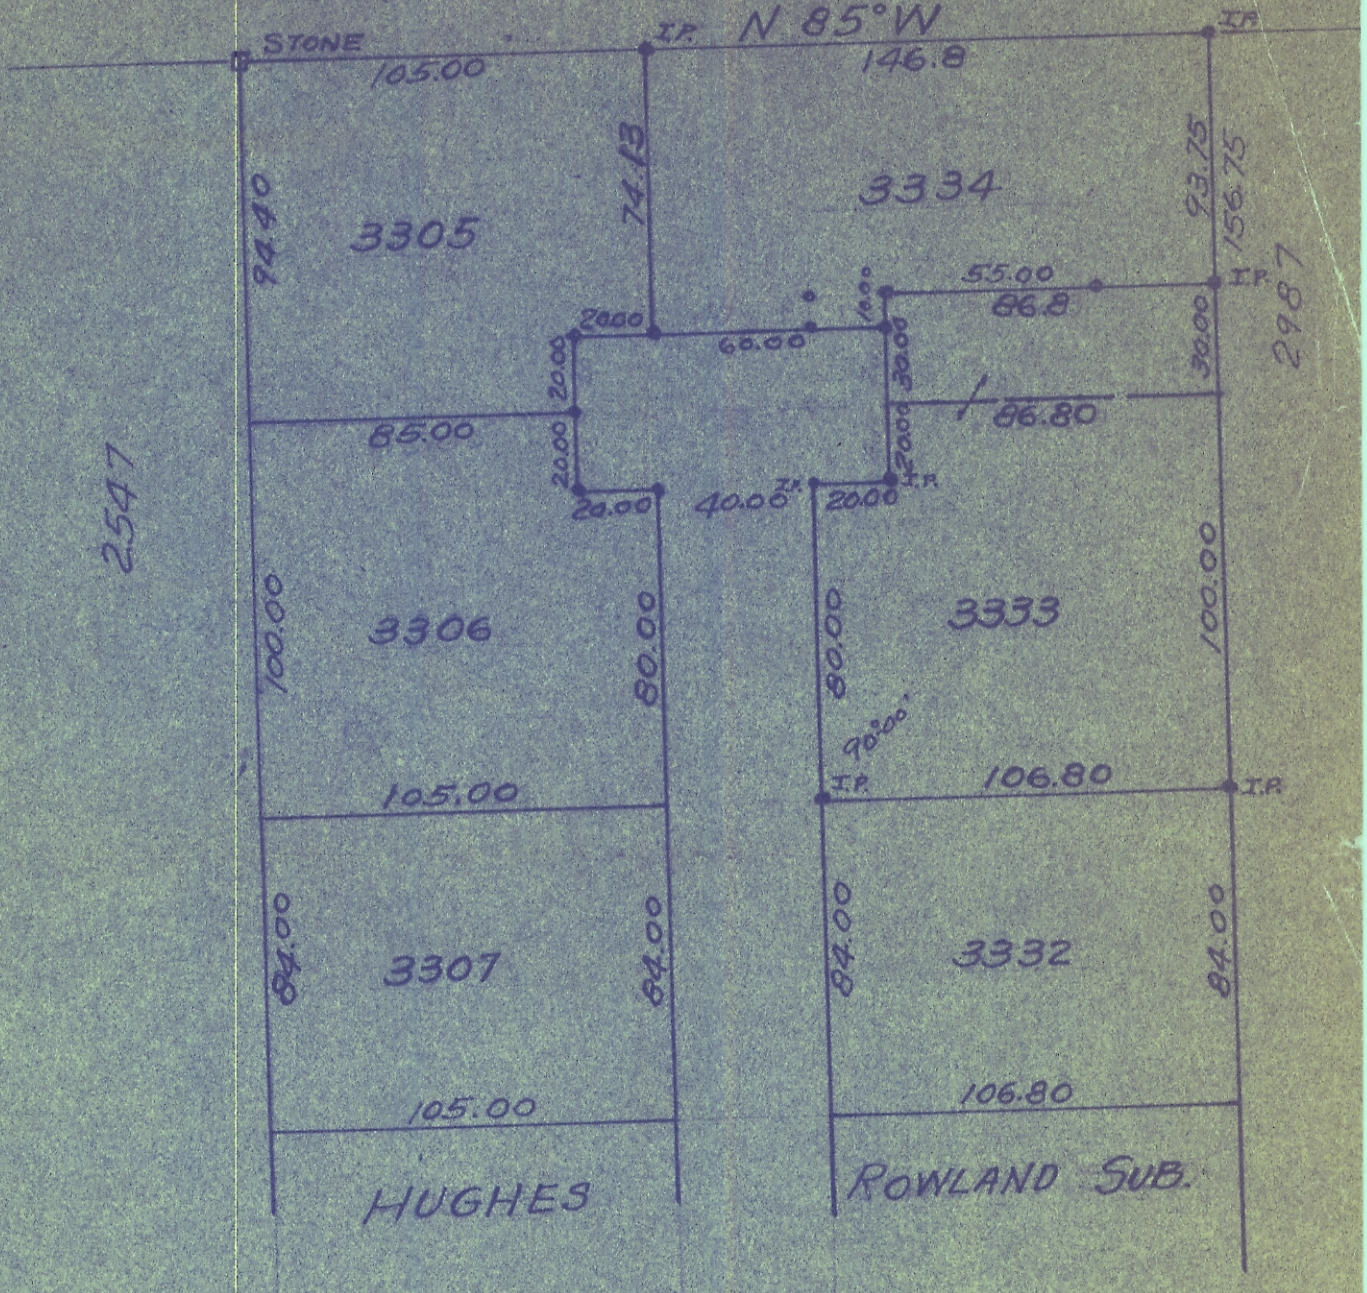

RESURVEY OF LOT 3333 & PART OF LOT 3334 LOCATED IN HUGHES - ROWLAND SUBDIVISION PART OF LEASE LOT No. 26, SECT. 4, T. 9, R-14, ATHENS TWP, CITY OF ATHENS, ATHENS, OHIO.
SURVEYEYED BY F.A. DIXON
SCALE 1" = 50' JUNE 14, 1962