

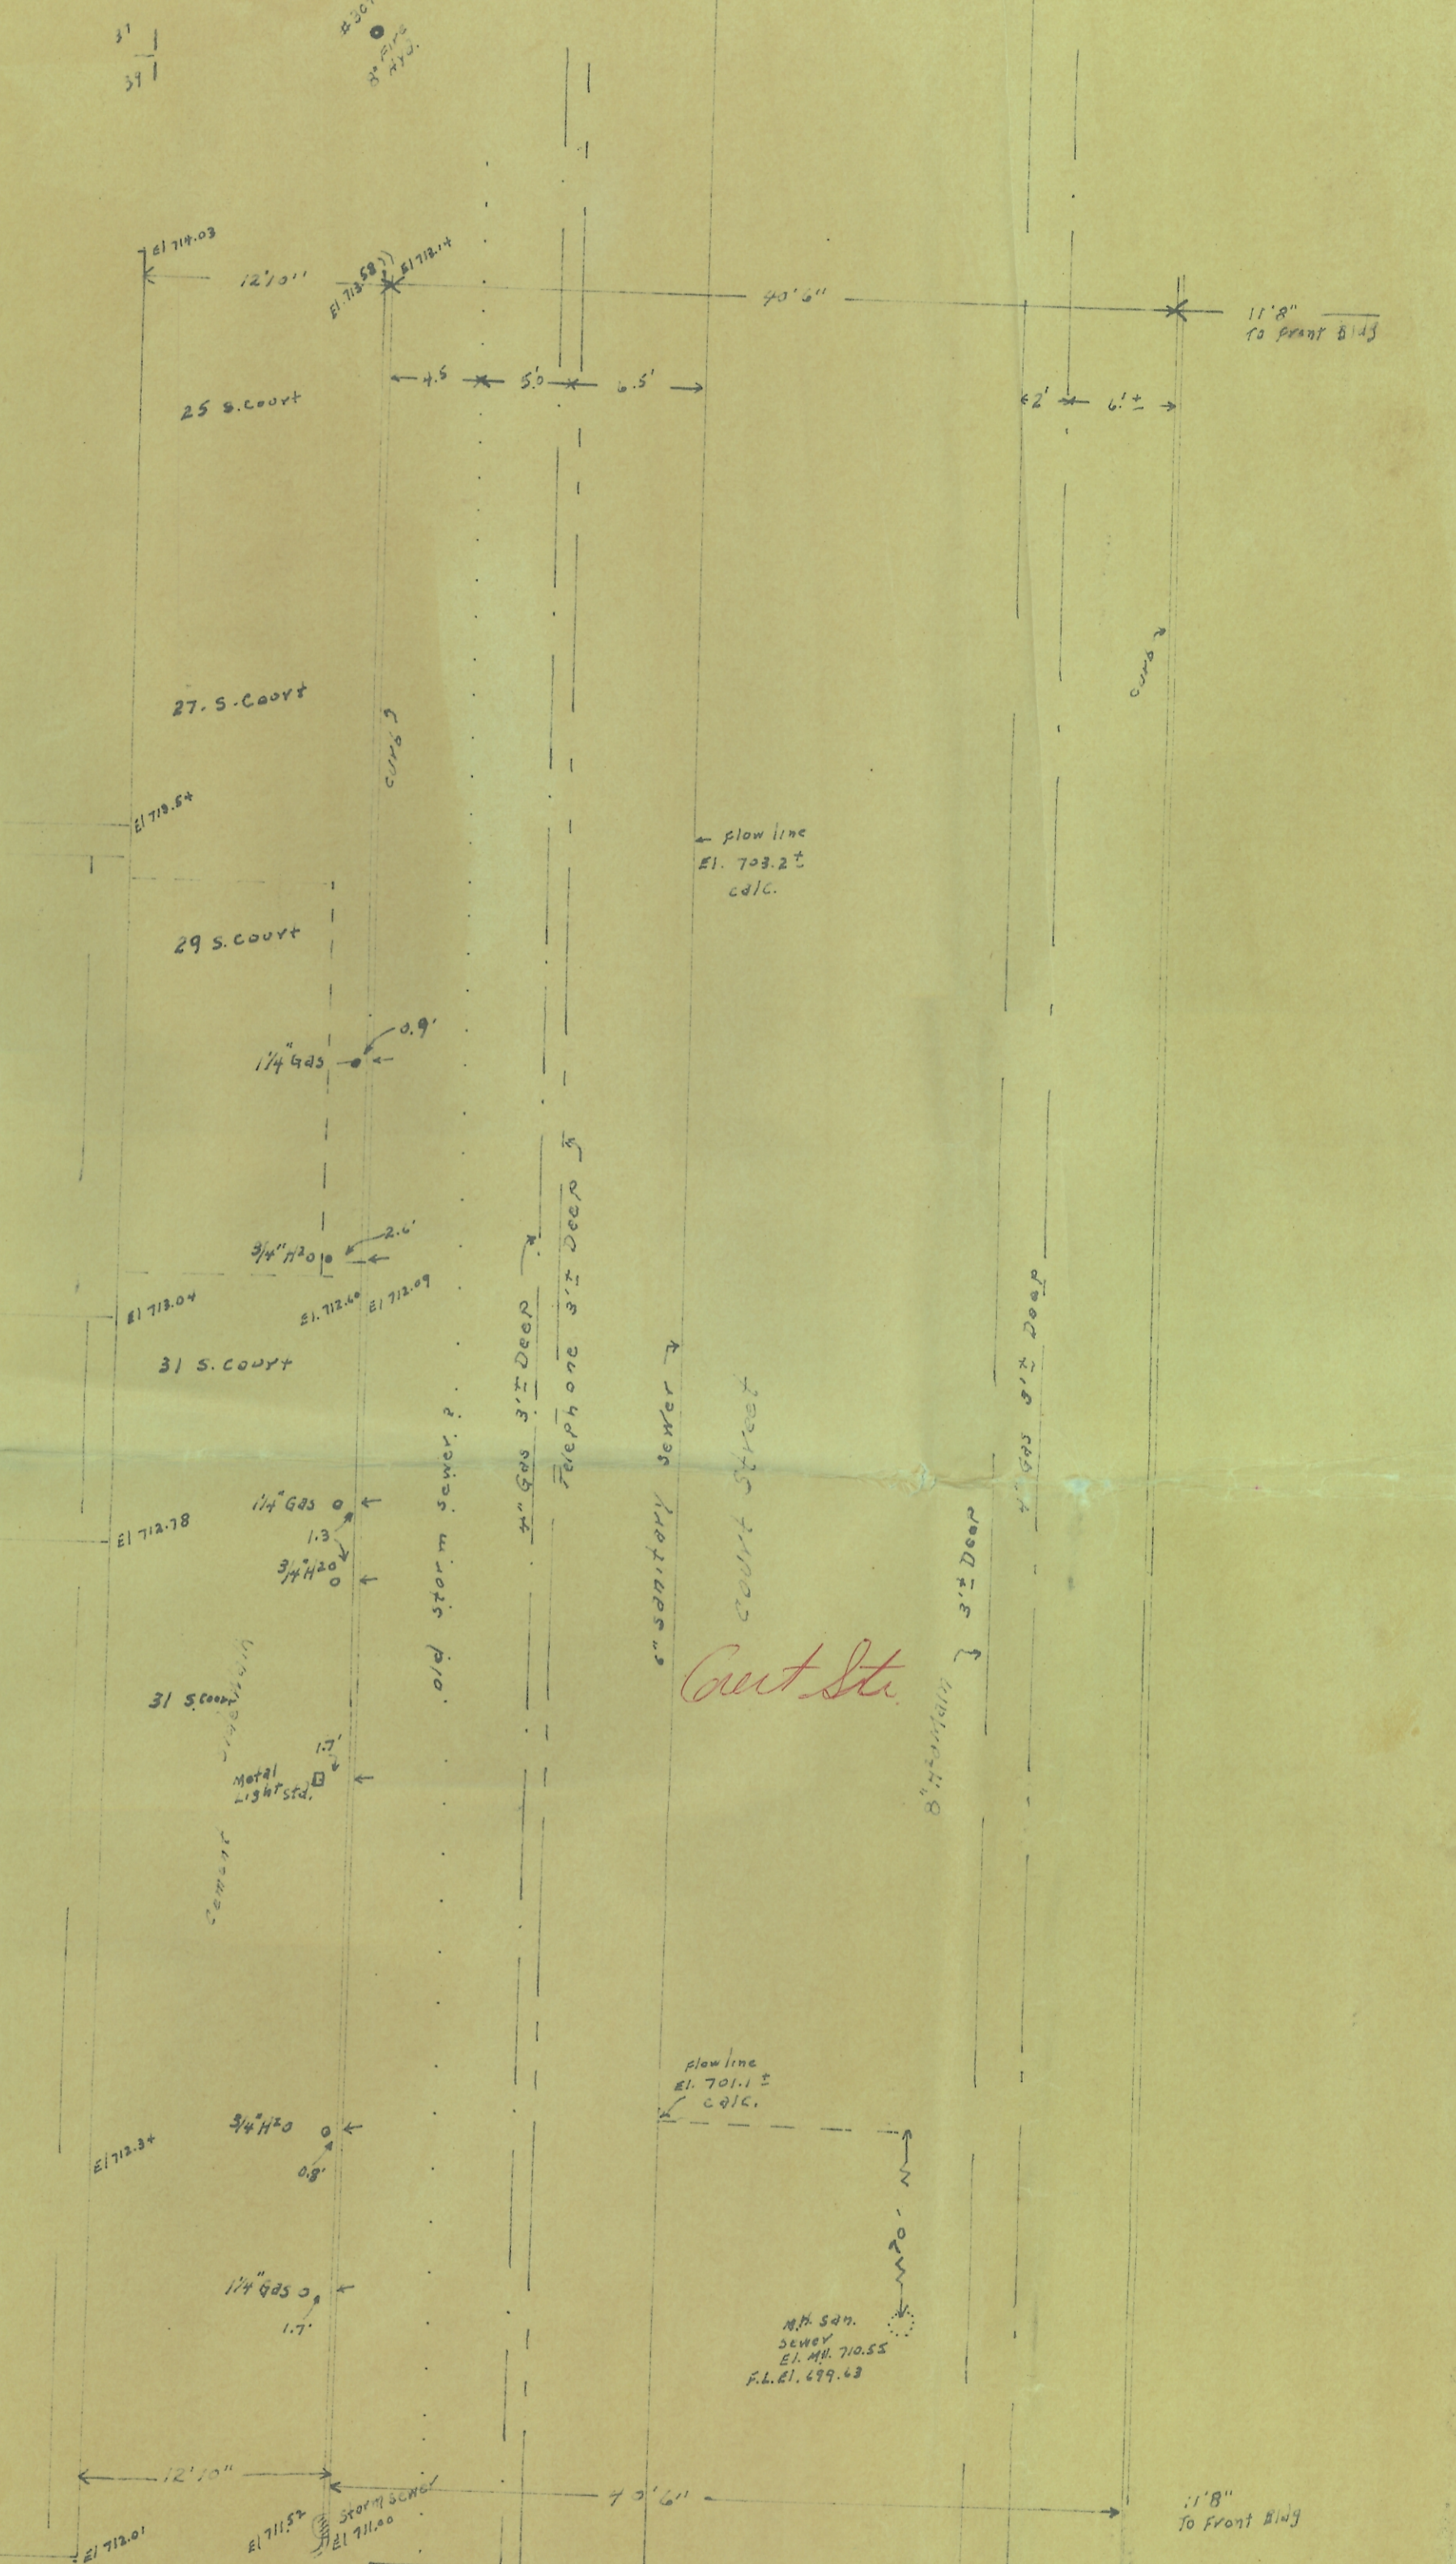


Mag. North  
Scale 1/8" = 10'

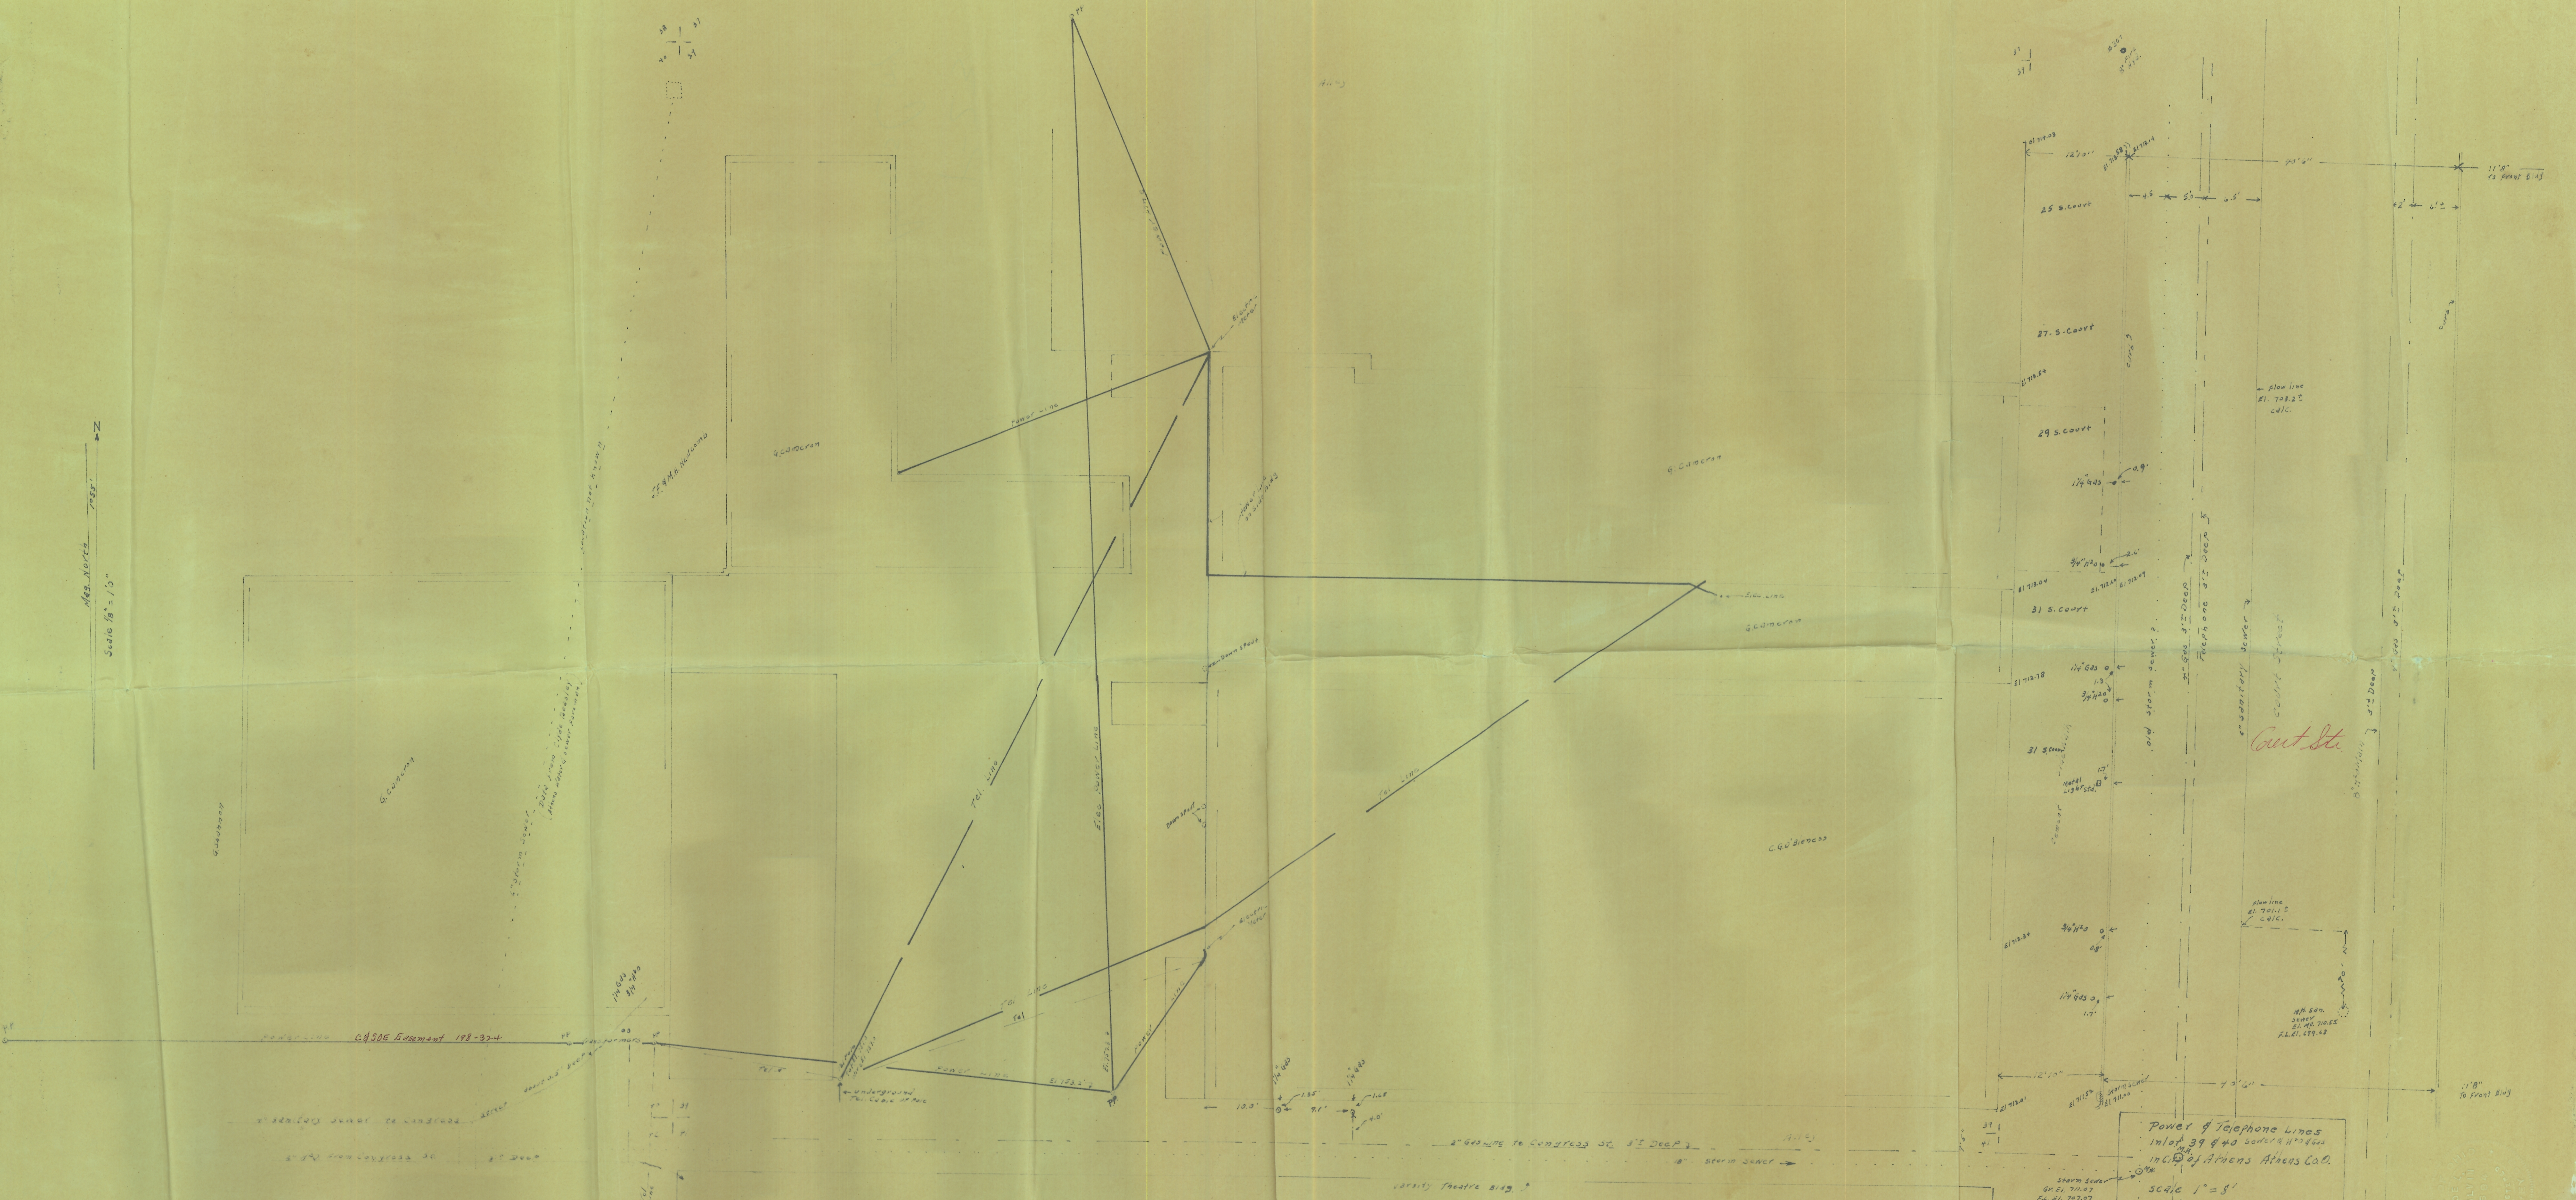

Power & Telephone Lines  
Info. 39 & 40 South 27th St  
in City of Athens Athens Co. Ga.  
Scale 1" = 5'  
J. L. Calhoun  
Reg. S.P. 1484

P-23  
JG 9  
MOTS  
39440

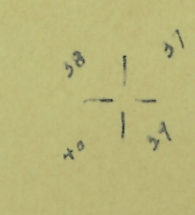