


ATHENS COUNTY AUDITOR TAX PLAT

Approx. Scale 1"=400' or 6 Chains

SEC. 2

Athens Twp.

T9-R14

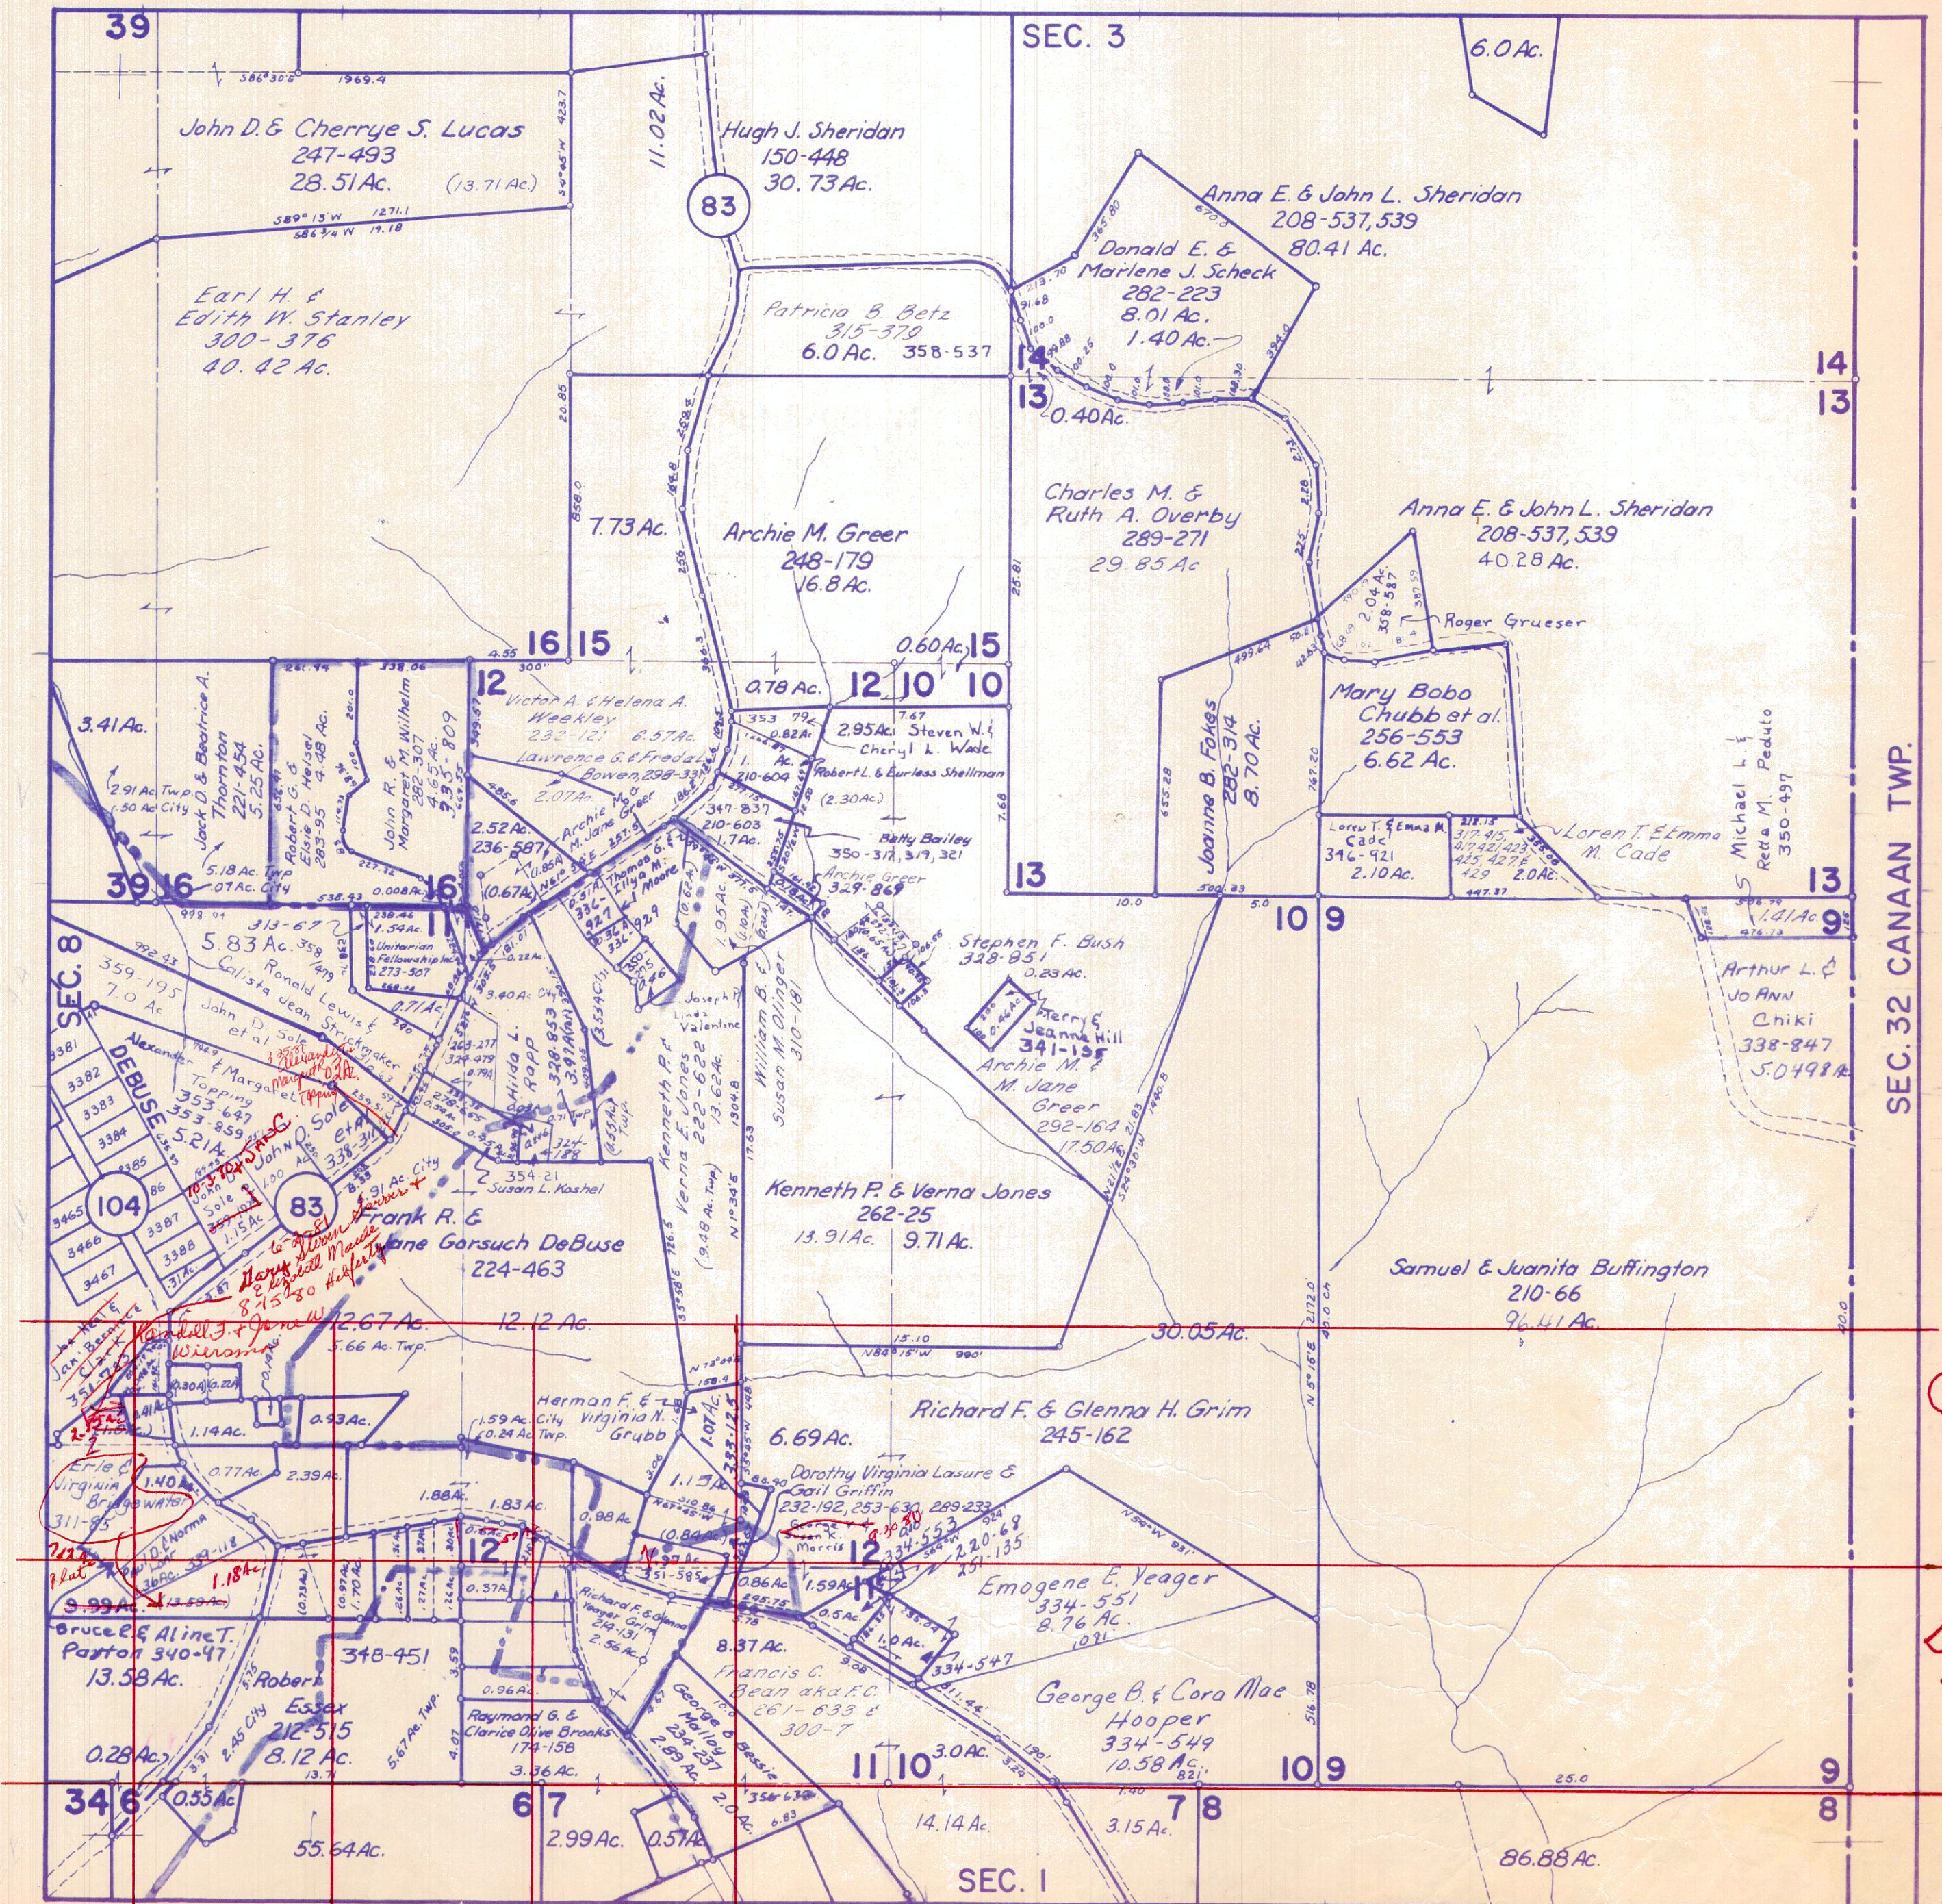

Revised to