


SOUTHEASTERN LAND SURVEYS

LEONARD F. SWOYER
REGISTERED PROFESSIONAL LAND SURVEYOR

3428 Pleasant Hill Road
Athens, Ohio 45701
614/593-8701

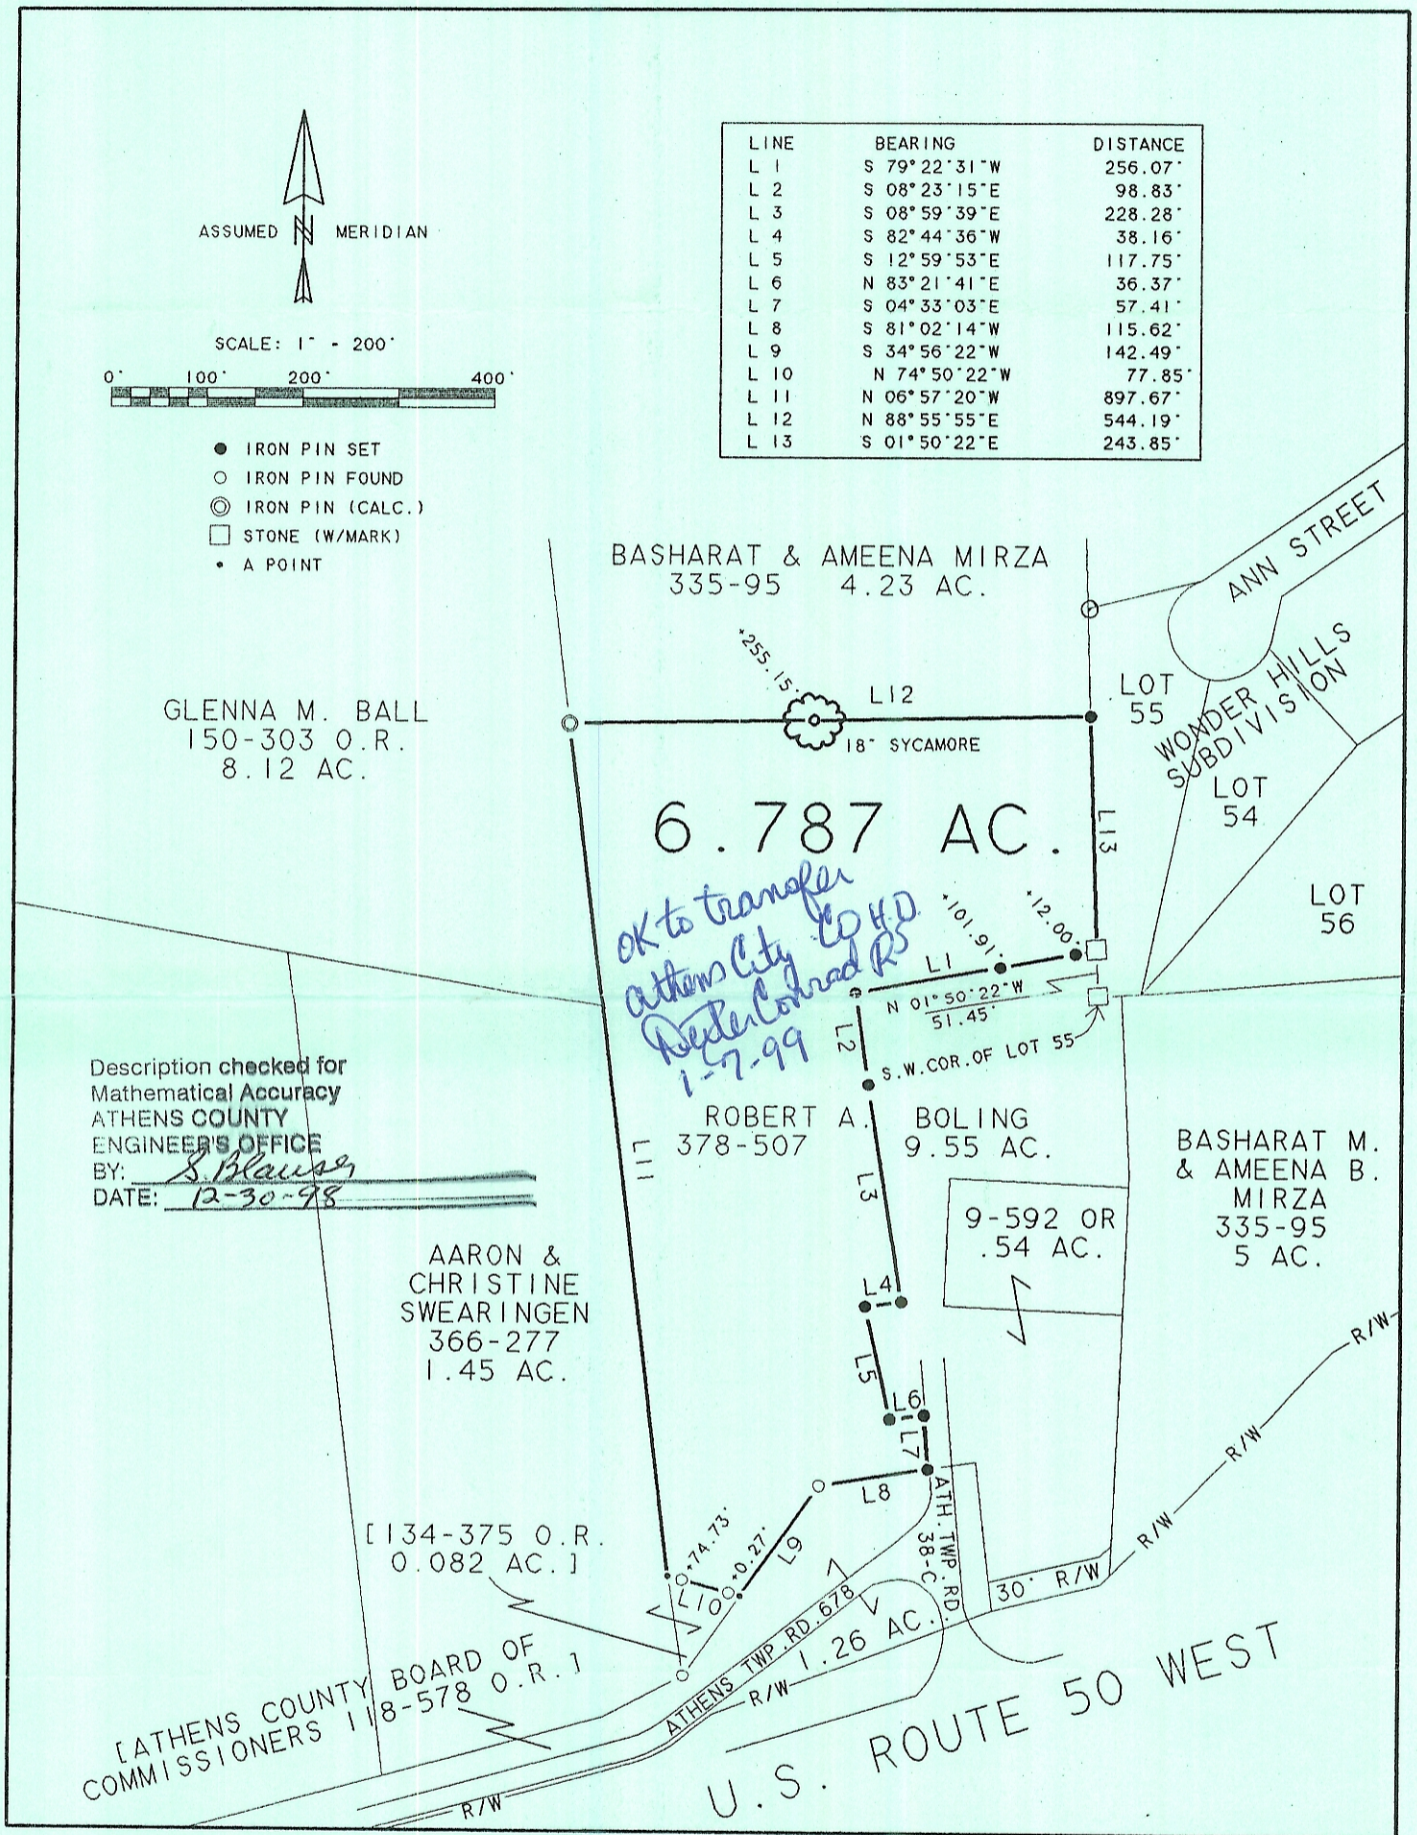

Plat of a 6.787 Acre Tract Scale 1" = 200'

Surveyed for Mr. Robert Boling Date 12/24/98

Subdivision Lease Lot 73

Township Athens Section 19 & 13 Town 9 Range 14

Corporation --- County Athens State Ohio

Leonard F. Swoyer Jr.

Leonard F. Swoyer Jr. Reg. Prof. Land Surveyor No. 6765