


ME 38.78 AC

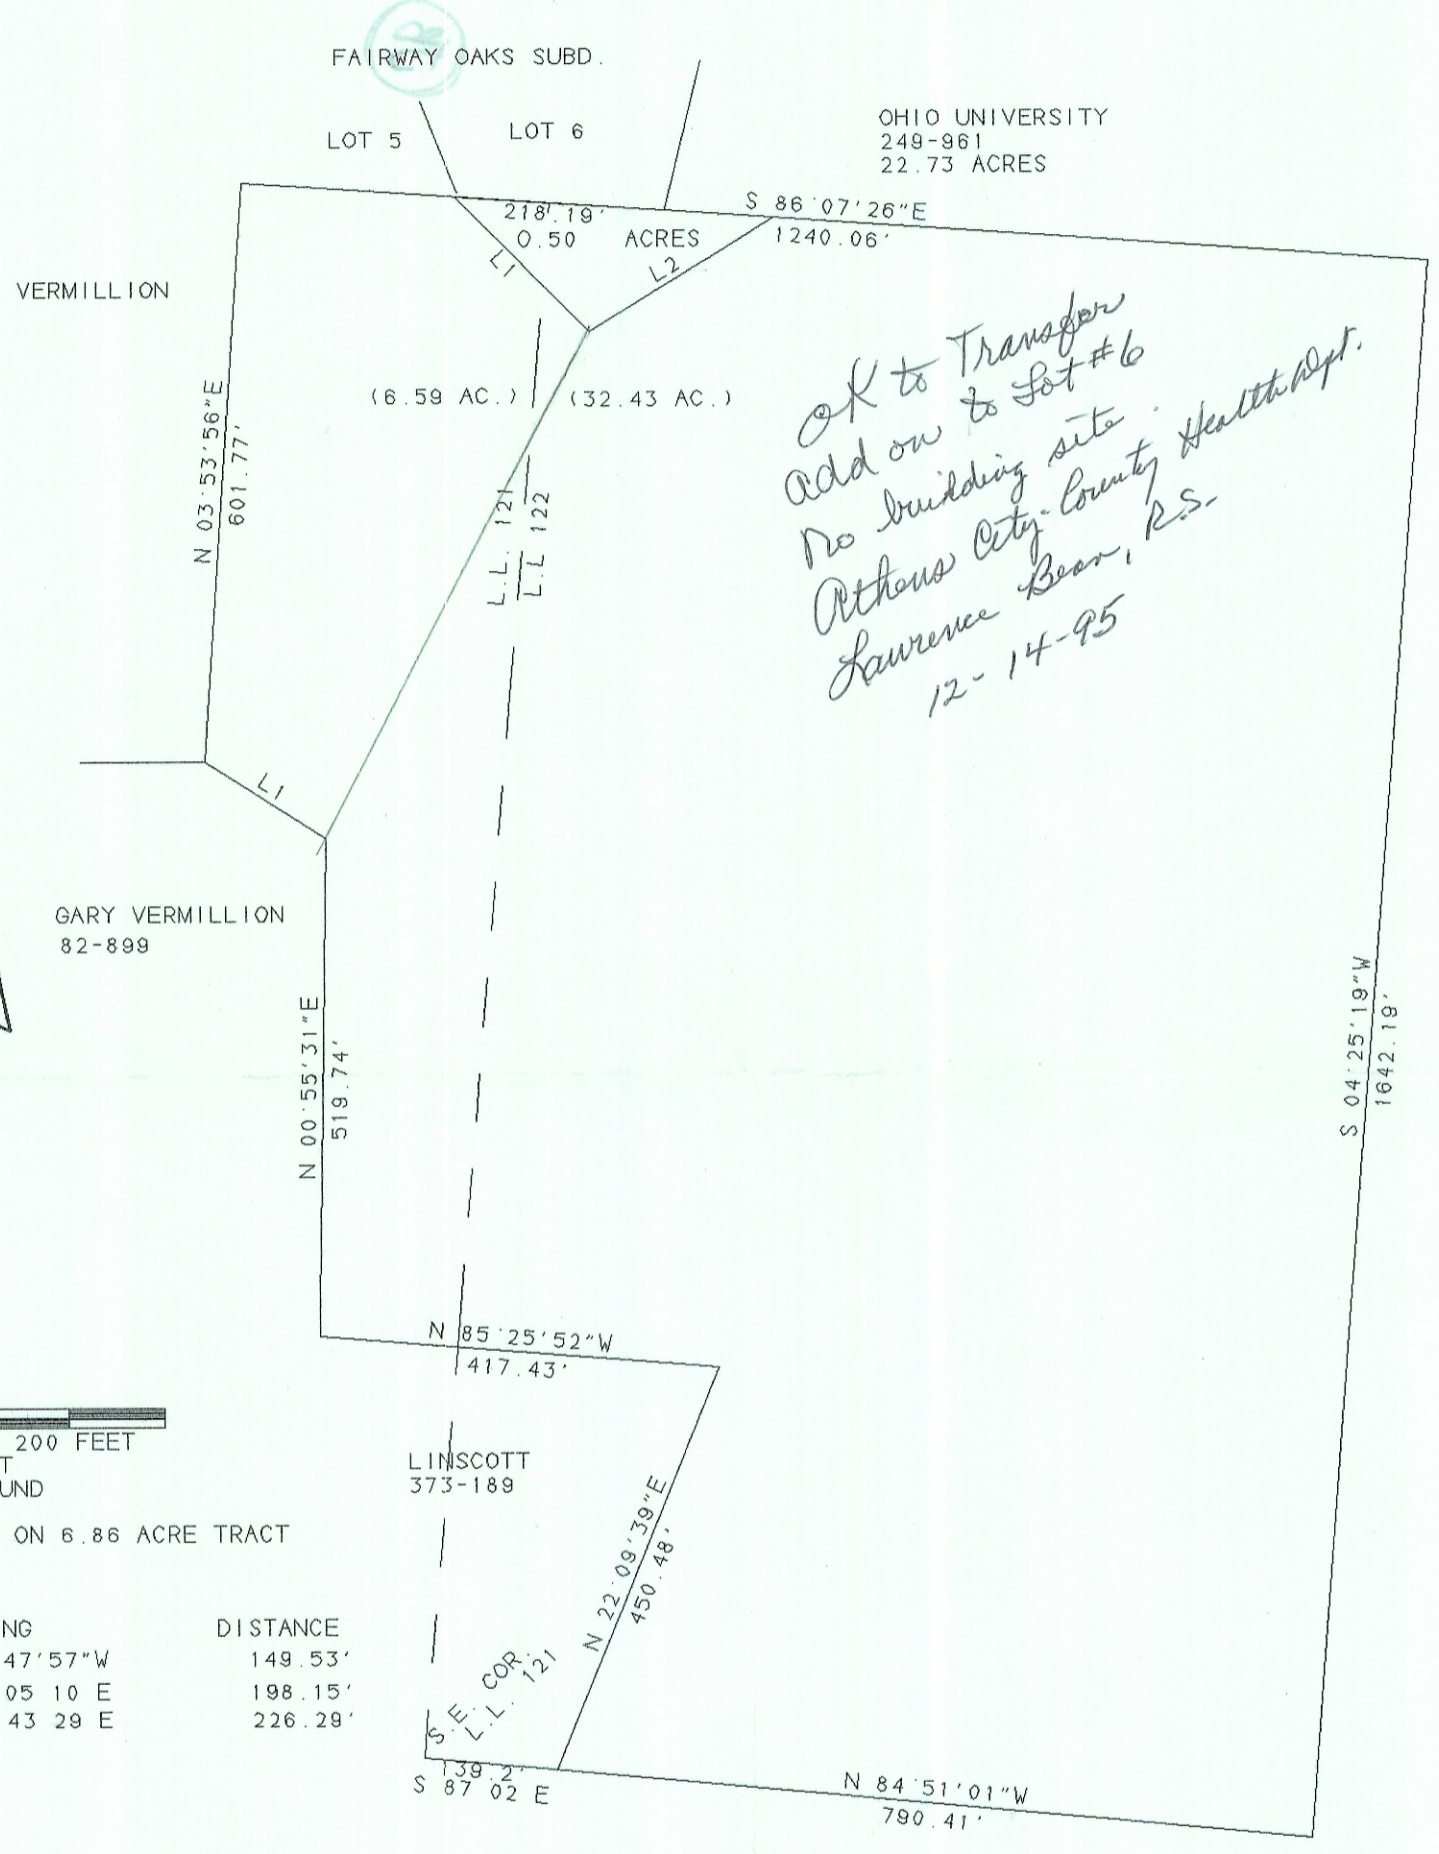

SCALE 1 INCH = 200 FEET
 = IRON PIN SET
 = IRON PIN FOUND
 = STONE FOUND
 BEARINGS BASED ON 6.86 ACRE TRACT

LINE	BEARING	DISTANCE
L 11	N 57° 47' 57" W	149.53'
L 1	S 45° 05' 10" E	198.15'
L 2	N 58° 43' 29" E	226.29'

SURVEY OF A 38.78 ACRE TRACT
 IN SECTION 26, T.9, R.14,
 ATHENS TWP., ATHENS CO., OHIO
 SURVEYED NOVEMBER 1995

JOHN M. BRANNER P.S. 6805
 12500 N. PEACHRIDGE ROAD
 ATHENS, OHIO 614-592-5778