


o = Iron Pin Set  
● = Iron Pin Found

Scale 1"=100'

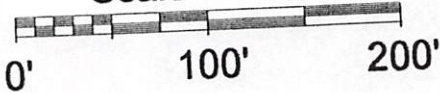

Line	Bearing	Distance
1	S 87°10'34"W	50.00'
2	S 75°42'37"E	69.34'



Moore 369-607

Description Checked for  
Mathematical Accuracy  
Athens County  
ENGINEER'S OFFICE

BY: K. Anteb  
DATE: 9/12/05

Moore 369-605

*OK to transfer per  
Athens Co. Health Dept  
Check all on R.S.  
9/13/05*

PLAT OF SURVEY OF A 5.018 Ac. TRACT

SURVEYED FOR Don LINDER

SUBDIVISION FARM LOT 106

TOWNSHIP ATHENS SECTION 32 TOWN 9 RANGE 14

CORPORATION - COUNTY ATHENS STATE OHIO

SCALE 1"= 100' DATE AUG 2005

Kenneth E. Highland  
80 Fayette St.  
Nelsonville, Ohio 45764  
740-753-1264

Kenneth E. Highland S-7581

