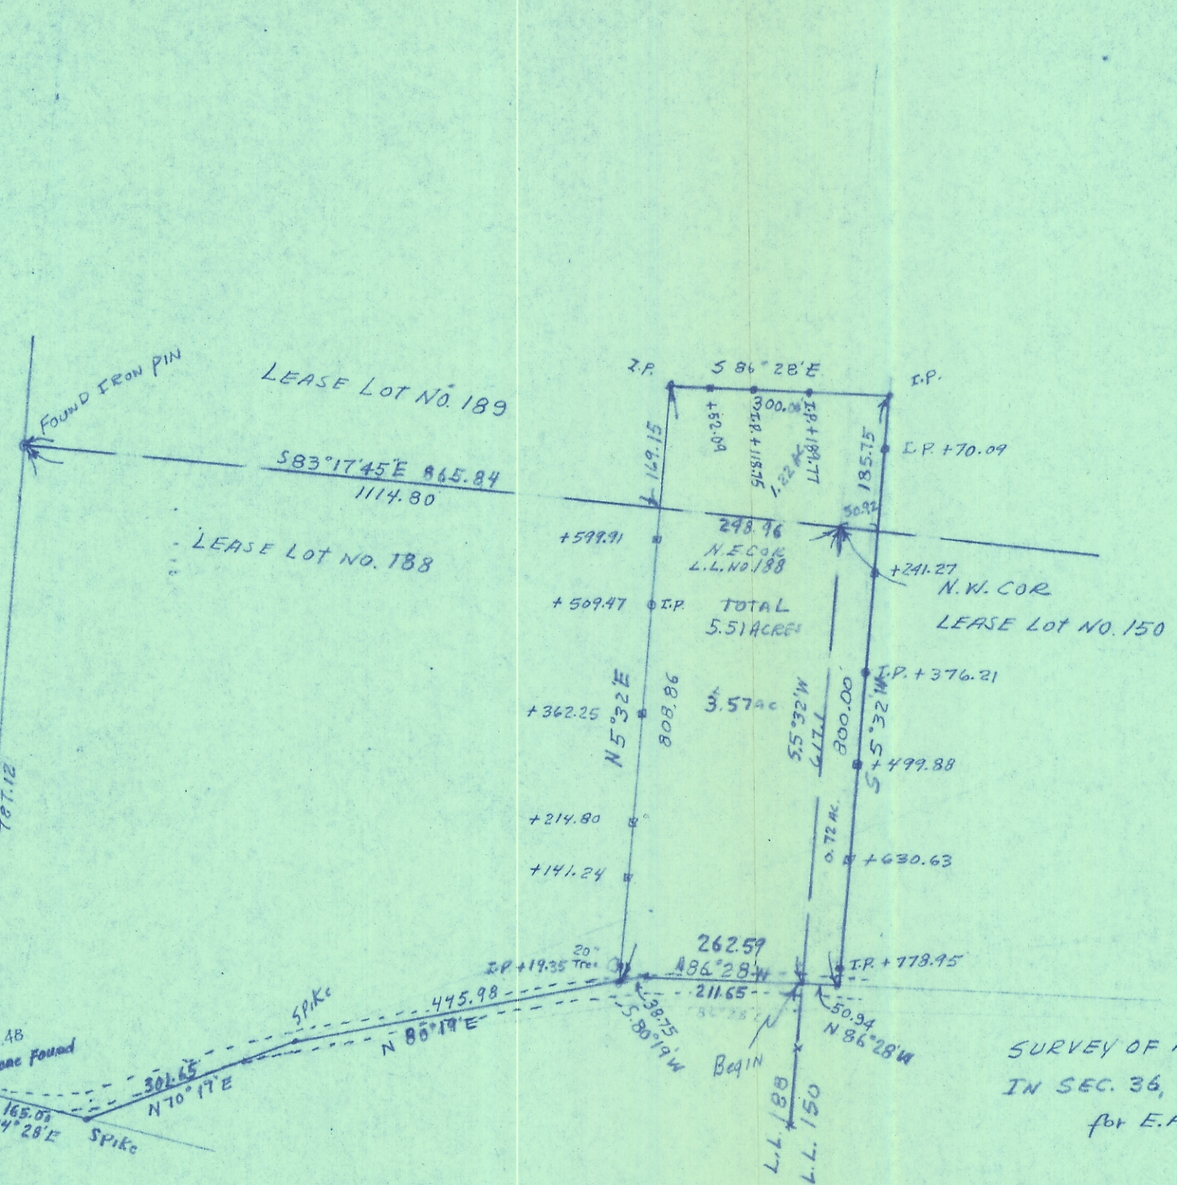

SURVEY OF A 5.51 ACRE TRACT IN LEASE LOTS 188, 189 & 150,
IN SEC. 36, T. 9, R. 14, ATHENS TOWNSHIP, ATHENS COUNTY, O.
for E.A. COTTINGHAM & TIM WILLIAMS

SURVEYED APRIL 1973, by HAROLD D. WHALEY

Harold D. Whaley

REG. SURV. NO. 4986