


ATH 3

1.99 AC

3.01 AC

Handwritten scribbles and notes on the right side of the map.

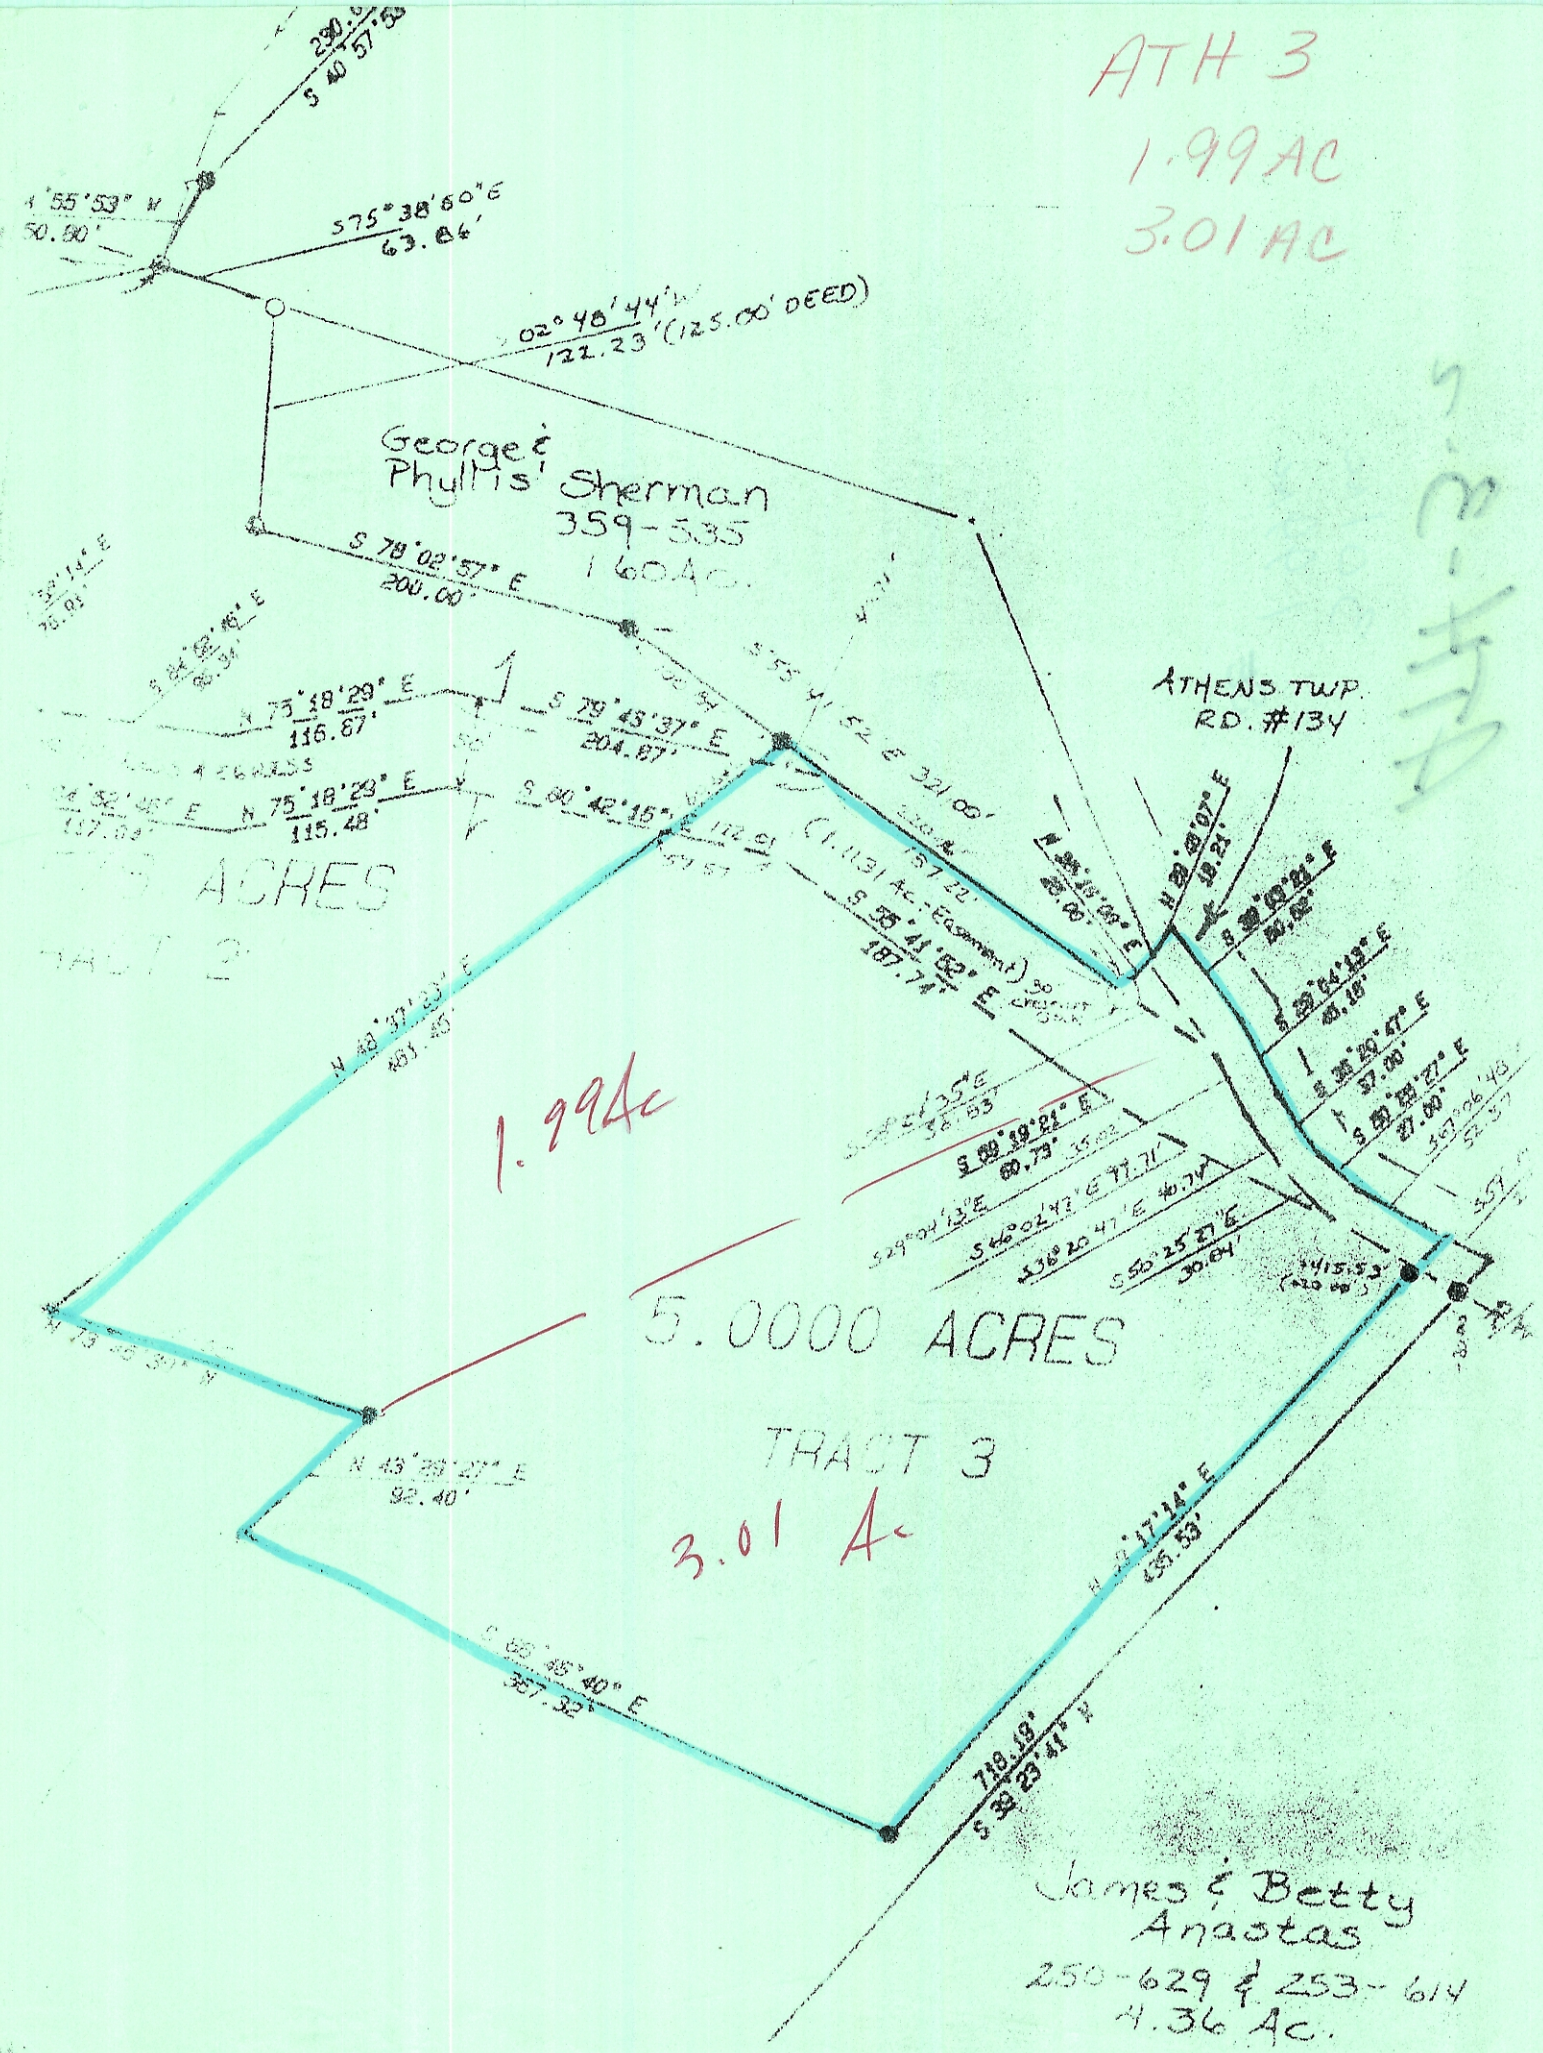

George &  
Phyllis Sherman  
359-535  
1.60 AC

ATHENS TWP.  
RD. #134

1.99 AC

5.0000 ACRES

TRACT 3

3.01 AC

James & Betty  
Anastas  
250-629 & 253-614  
4.36 AC

N 55° 53' W  
50.90'

S 75° 38' 60" E  
63.84'

S 02° 48' 44" W  
121.23' (125.00' DEED)

N 75° 18' 29" E  
116.87'

S 79° 45' 37" E  
204.87'

N 75° 18' 29" E  
115.48'

S 80° 42' 15" E  
112.91'

S 52° 11' 52" E  
321.00'

S 55° 41' 52" E  
187.74'

S 59° 19' 21" E  
60.73'

S 42° 02' 47" E  
40.74'

S 58° 25' 27" E  
30.84'

N 28° 07' 07" E  
48.21'

S 89° 09' 21" E  
60.02'

S 22° 04' 49" E  
60.18'

S 35° 20' 47" E  
57.00'

S 85° 23' 27" E  
27.00'

S 67° 06' 48" E  
52.37'

N 48° 37' 23" E  
101.25'

N 45° 29' 27" E  
92.40'

S 65° 45' 40" E  
367.32'

N 39° 17' 14" E  
25.53'

S 33° 23' 41" N  
719.19'

445.53'  
(220.00')