Claira & Amey Weihr Survey, In lot # 2039, Parts lot # 189 and Outlot # 170. Athens.

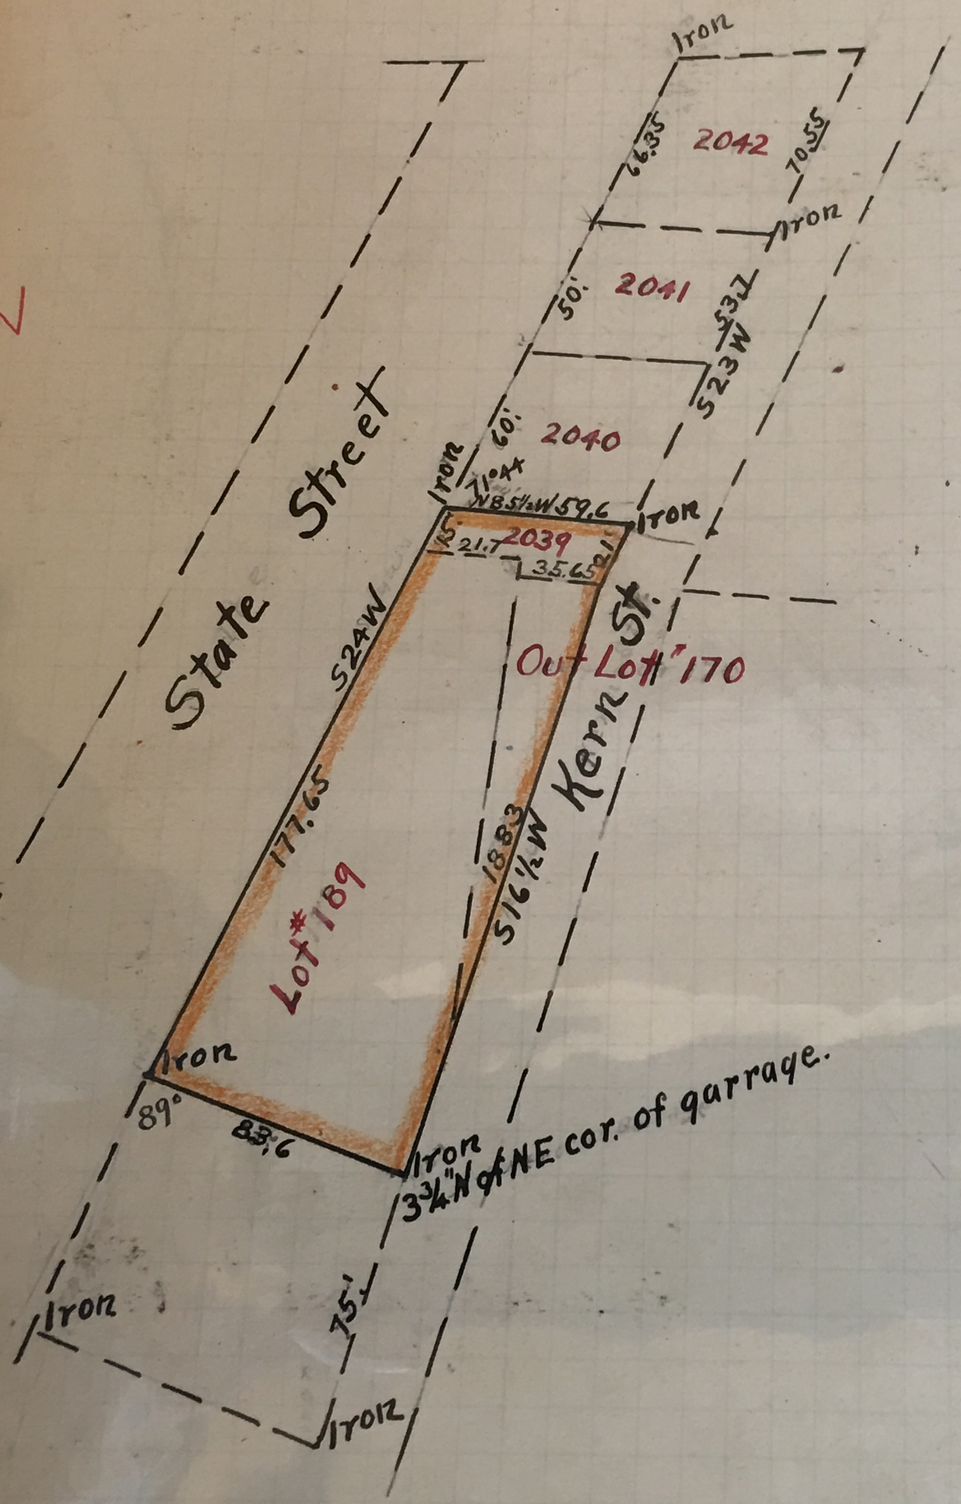

Scale 50' = 1 inch
Surveyed July 22. 1926.
Recorded July 23. 1926.
S H. Hibbard
and
Harry Dusz.
Surveyors