

PUBLIC ROAD PETITION RECEIVED

Rev. Code, Sec. 5553.04

SEP 14 2011

Athens County Commissioners, 19.....

Ohio,.....

To the Honorable Board of County Commissioners of..... County, Ohio:

The undersigned petitioners, freeholders of said County, residing in the vicinity of the proposed improvement hereinafter described, respectfully represent that the public convenience and welfare require the ¹vacation of ²..... a Public Road on the line hereinafter described; and make application to you to institute and order proper proceedings in the premises, for ¹..... such road; the same ³.....being a road on the State Highway System.
(not)

The following is the general route and termini of said road:

Beginning at ⁴ THE NORTHEAST CORNER OF LOT 496 OF

BESSEMER,

THENCE ALONG THE NORTH LINE OF A 16.00' ALLEY, EAST, 16.00 FEET TO THE NORTHWEST CORNER OF LOT 497,

THENCE ALONG THE WEST LINE OF LOT 497, SOUTH, 150.00' TO THE SOUTHWEST CORNER OF SAID LOT 497,

THENCE ALONG THE SOUTH LINE OF SAID 16.00' ALLEY, WEST, 16.00' TO THE SOUTHEAST CORNER OF LOT 496,

THENCE ALONG THE EAST LINE OF LOT 496, NORTH, 150.00' TO THE PLACE OF BEGINNING CONTAINING 2400 SQ. FT. (0.55 Ac.)

Even Dishong

POI-01201050-02

16 X 150

Vacated Alley

Buchtel 1

11/23/11

pd.

Ordinance No. 09-12

Passed February 27, 2012

Thompson, Jeremy E + Amanda
P030620000700 (-01)

ORDINANCE 09-12

AN ORDINANCE VACATING A PORTION OF AN ALLEY IN THE BROOK'S ADDITION TO THE CITY OF NELSONVILLE BETWEEN GROVER STREET AND FRANK STREET.

8x125' vac
alley
W IL 722

WHEREAS, pursuant to *Ohio Revised Code §723.05*, the legislative authority of a municipal corporation is authorized to vacate a street or alley when there is good cause shown and there is no detriment to the general interest; and

WHEREAS, pursuant to *Ohio Revised Code §723.06*, petitioners Keith Weston and Jeremy Thompson request waiver of the notification requirement otherwise provided in *Ohio Revised Code §723.07* and pray the legislative authority vacate a portion of an alley in the Brook's Addition to the Village (now City) of Nelsonville, Ohio.

Keith Weston
P0020000600 (-01)

NOW THEREFORE, BE IT ORDAINED BY THE COUNCIL OF THE CITY OF NELSONVILLE, ATHENS COUNTY, OHIO AS FOLLOWS:

8x125' vac alley
E IL 706

1. Pursuant to *Ohio Revised Code §723.05*, a portion of an alley sixteen (16) feet in width between Grover Street and Frank Street and between Lots 706 and 722 in the Brook's Addition to the Village (now City) of Nelsonville, also known as 212 and 214 Grover Street, is hereby vacated to Keith Weston and Jeremy Thompson, with the full portion of the alley retained by Keith Weston, his heirs, successors or assigns and in accordance with EXHIBIT "A" attached hereto and incorporated herein by reference.
2. Pursuant to *Ohio Revised Code §723.041*, the City of Nelsonville retains a permanent easement for the purpose of maintaining, operating, renewing, reconstructing, or removing utility facilities whether publicly or privately owned.
3. The Clerk of Council is hereby directed to file a copy of this ordinance with the Athens County Auditor and Athens County Recorder with cross reference to the recorded subdivision plat.
4. This ordinance shall become effective at the earliest date provided by law.


Ex
Pd
4-16-12

Duly enacted by Council on second reading this 27th day of February, 2012.

NELSONVILLE CITY COUNCIL



President of Council

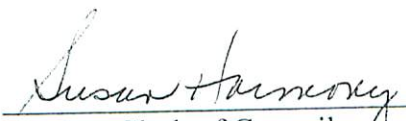

Clerk of Council


First Reading: 02/13/12
Second Reading: 02/27/12

8x125'


EXHIBIT "A"



FRANK ST.

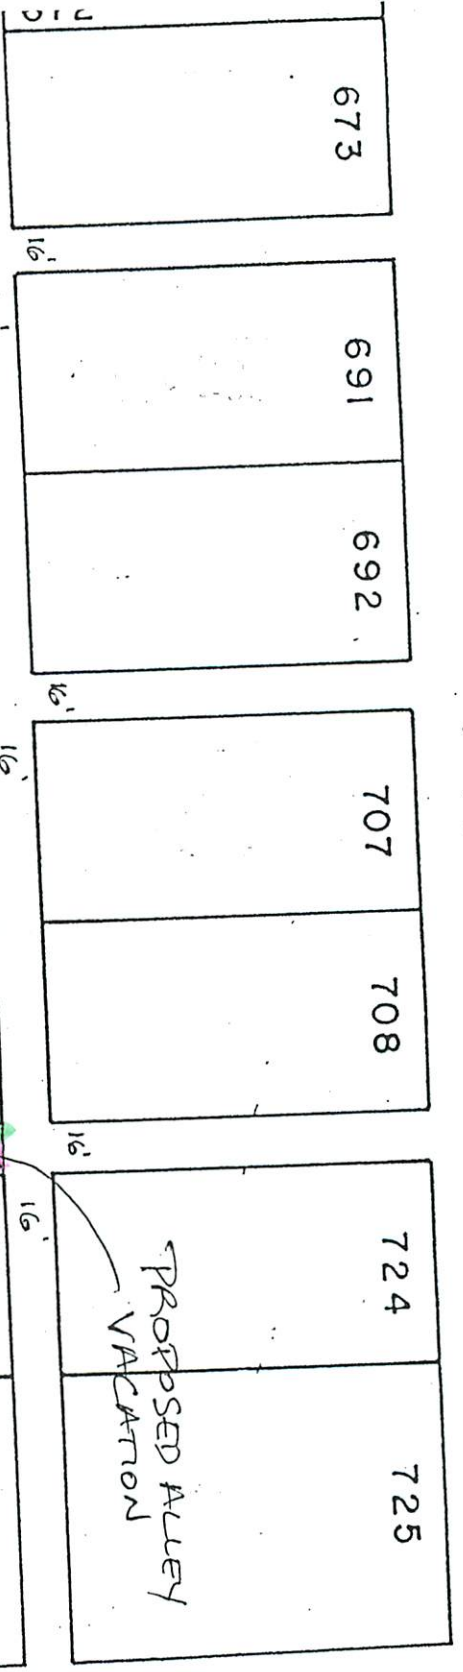

GROVER ST.

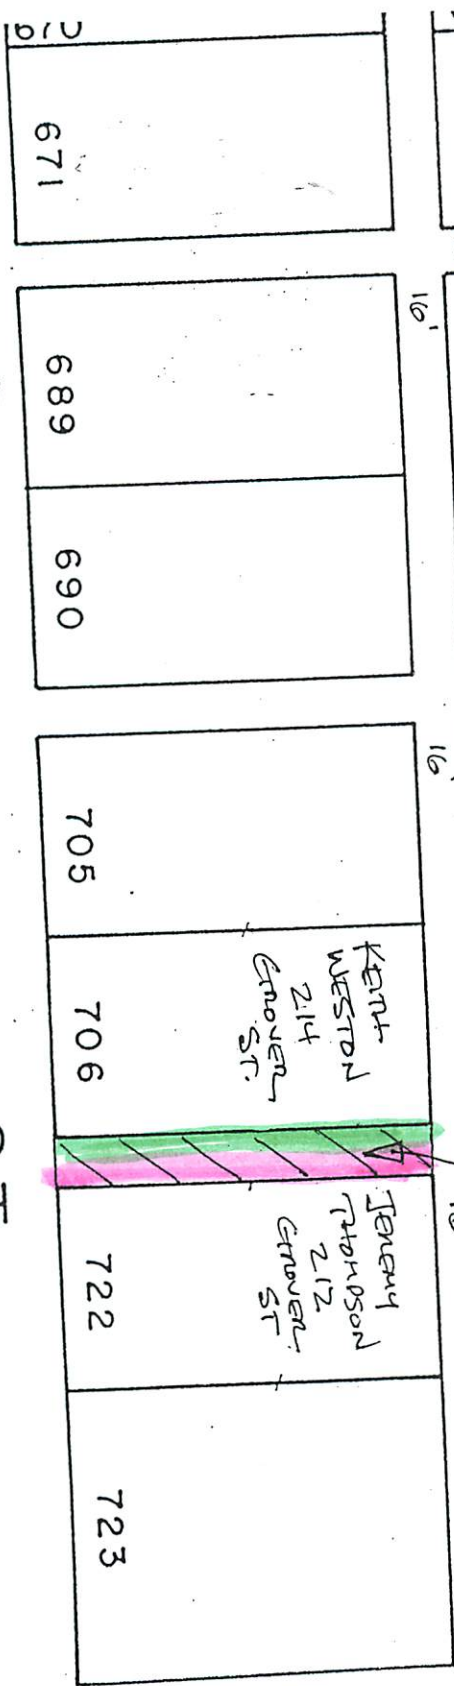

BROOK (NOW FREDERICK ST)

