


For Vacation of Road See Need Vol 369 Pg 961
(Corrected) " " 369 Pg 1119

OFFICE OF THE AUDITOR OF ATHENS COUNTY, OHIO, IN THE MATTER OF THE VACATION OF LOTS FOR WILLIAM F. LANGSTON, PURSUANT TO SECTION 711.25, REVISED CODE OF OHIO
ORDER AND CERTIFICATE TO WILLIAM F. LANGSTON, ATHENS, OHIO PURSUANT TO YOUR APPLICATION FILED IN THIS OFFICE ON OR ABOUT THE 25th DAY OF MARCH, 1960, REQUESTING
the Auditor of Athens County, Ohio, to issue a certificate stating that Lots Nos. 1 to 9, inclus ive, of C. A. Hooper's subdivision, located in Farm Lot 74, Township 9,
Range 14, Athens Township, Athens County, Ohio, be vacated, as such, in conformity to Section 711.25 to Section 711.27, inclusive, Revised Code of Ohio, and
finding that you have fully complied with all provisions of law pertaining thereto. It is ordered that said lots be and they are hereby vacated and you are
directed to present this certificate to the Recorder of Athens County, Ohio, who shall write upon the plat in Volume 7, page 290, Records of Plats
of Athens County, Ohio, the word "vacated". Witness my hand and the seal of the Auditor of Athens County, Ohio, this 23 day of April, 1960.
J. W. Whaley, Auditor of Athens County, Ohio.
Copied from original Order Apr. 25, 1960.
s/ Claudis E. Chappel, Recorder
By Frank J. Evans Deputy

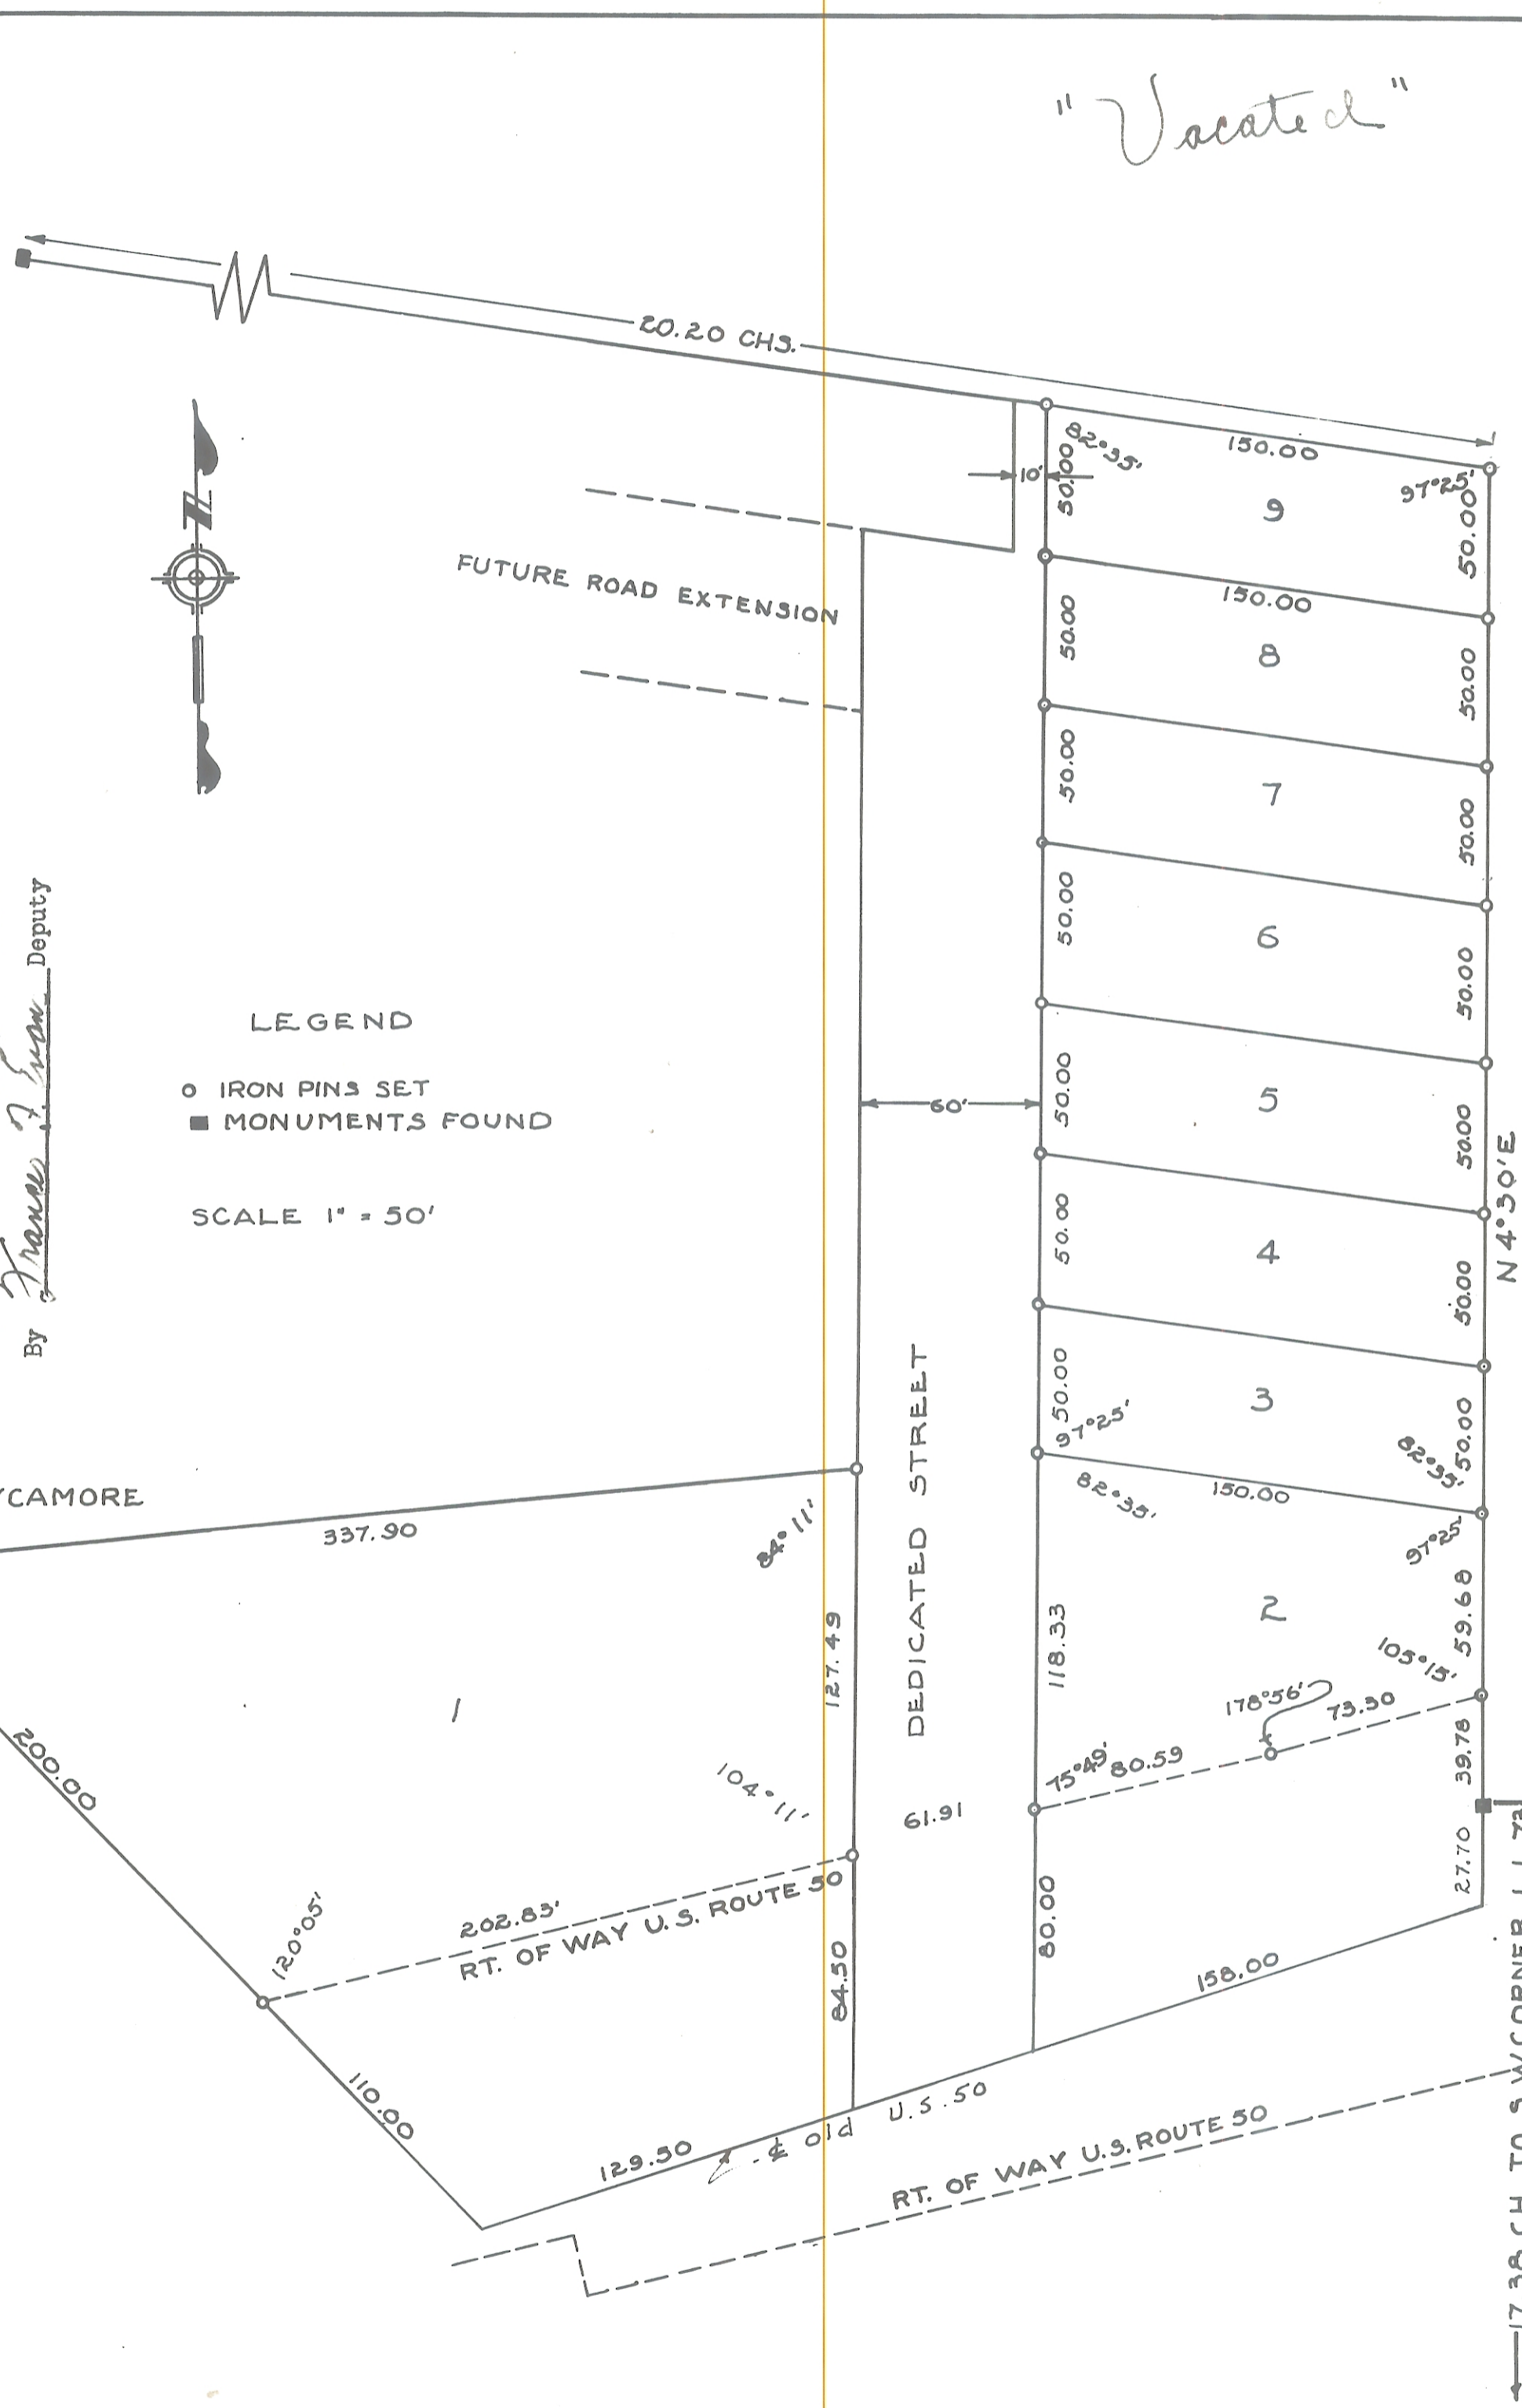

"Vacated"

C.A. HOOPER SUBDIVISION

Located in Farm Lot 74, Township 9, Range 14, Ohio River Survey, and containing 3.00 acres in lots and 0.71 acres in streets and roads.

SURVEYORS' CERTIFICATE

We do hereby certify that this plat of C.A. Hooper Subdivision is true and correct as surveyed by us in March 1956.

Clark and Sheeter, Registered Surveyors. George W. Clark Reg. Surv. 2364

OWNERS CERTIFICATE

We E. Paul Cotton and wife Grace H. Cotton do hereby certify that we are the owners of the land shown on this plat and do hereby acknowledge the making of this plat to be our voluntary act and deed, and do hereby dedicate the street to the public use forever

E. Paul Cotton
E. Paul Cotton
Grace H. Cotton
Grace H. Cotton

COUNTY ENGINEERS CERTIFICATE

I do hereby approve the acceptance of this plat.
County Engineer, Athens County, Ohio John D. ...

COMMISSIONERS CERTIFICATE

We do hereby certify that this plat of C.A. Hooper Subdivision has been approved by the Board of Commissioners of Athens County, Ohio.

W. Wakefield
Wayne Ward
Charles E. Bolin

ACKNOWLEDGMENT

State of Ohio }
County of Athens } ss
Before me, a notary public, in and for the County of Athens, State of Ohio appeared personally the above signed E. Paul Cotton and Grace H. Cotton who acknowledged the signing of this instrument to be their free act and deed.
Barbara J. ...
Notary public, Athens County, Ohio
My commission expires Aug. 27, 1958

Transferred May 23, 1956
County Auditor, Athens County
Received for Record June 1, 1956
Recorded Vol. ...
Claudis E. Chappel
County Recorder, Athens County, Ohio
Fee \$ 8.00