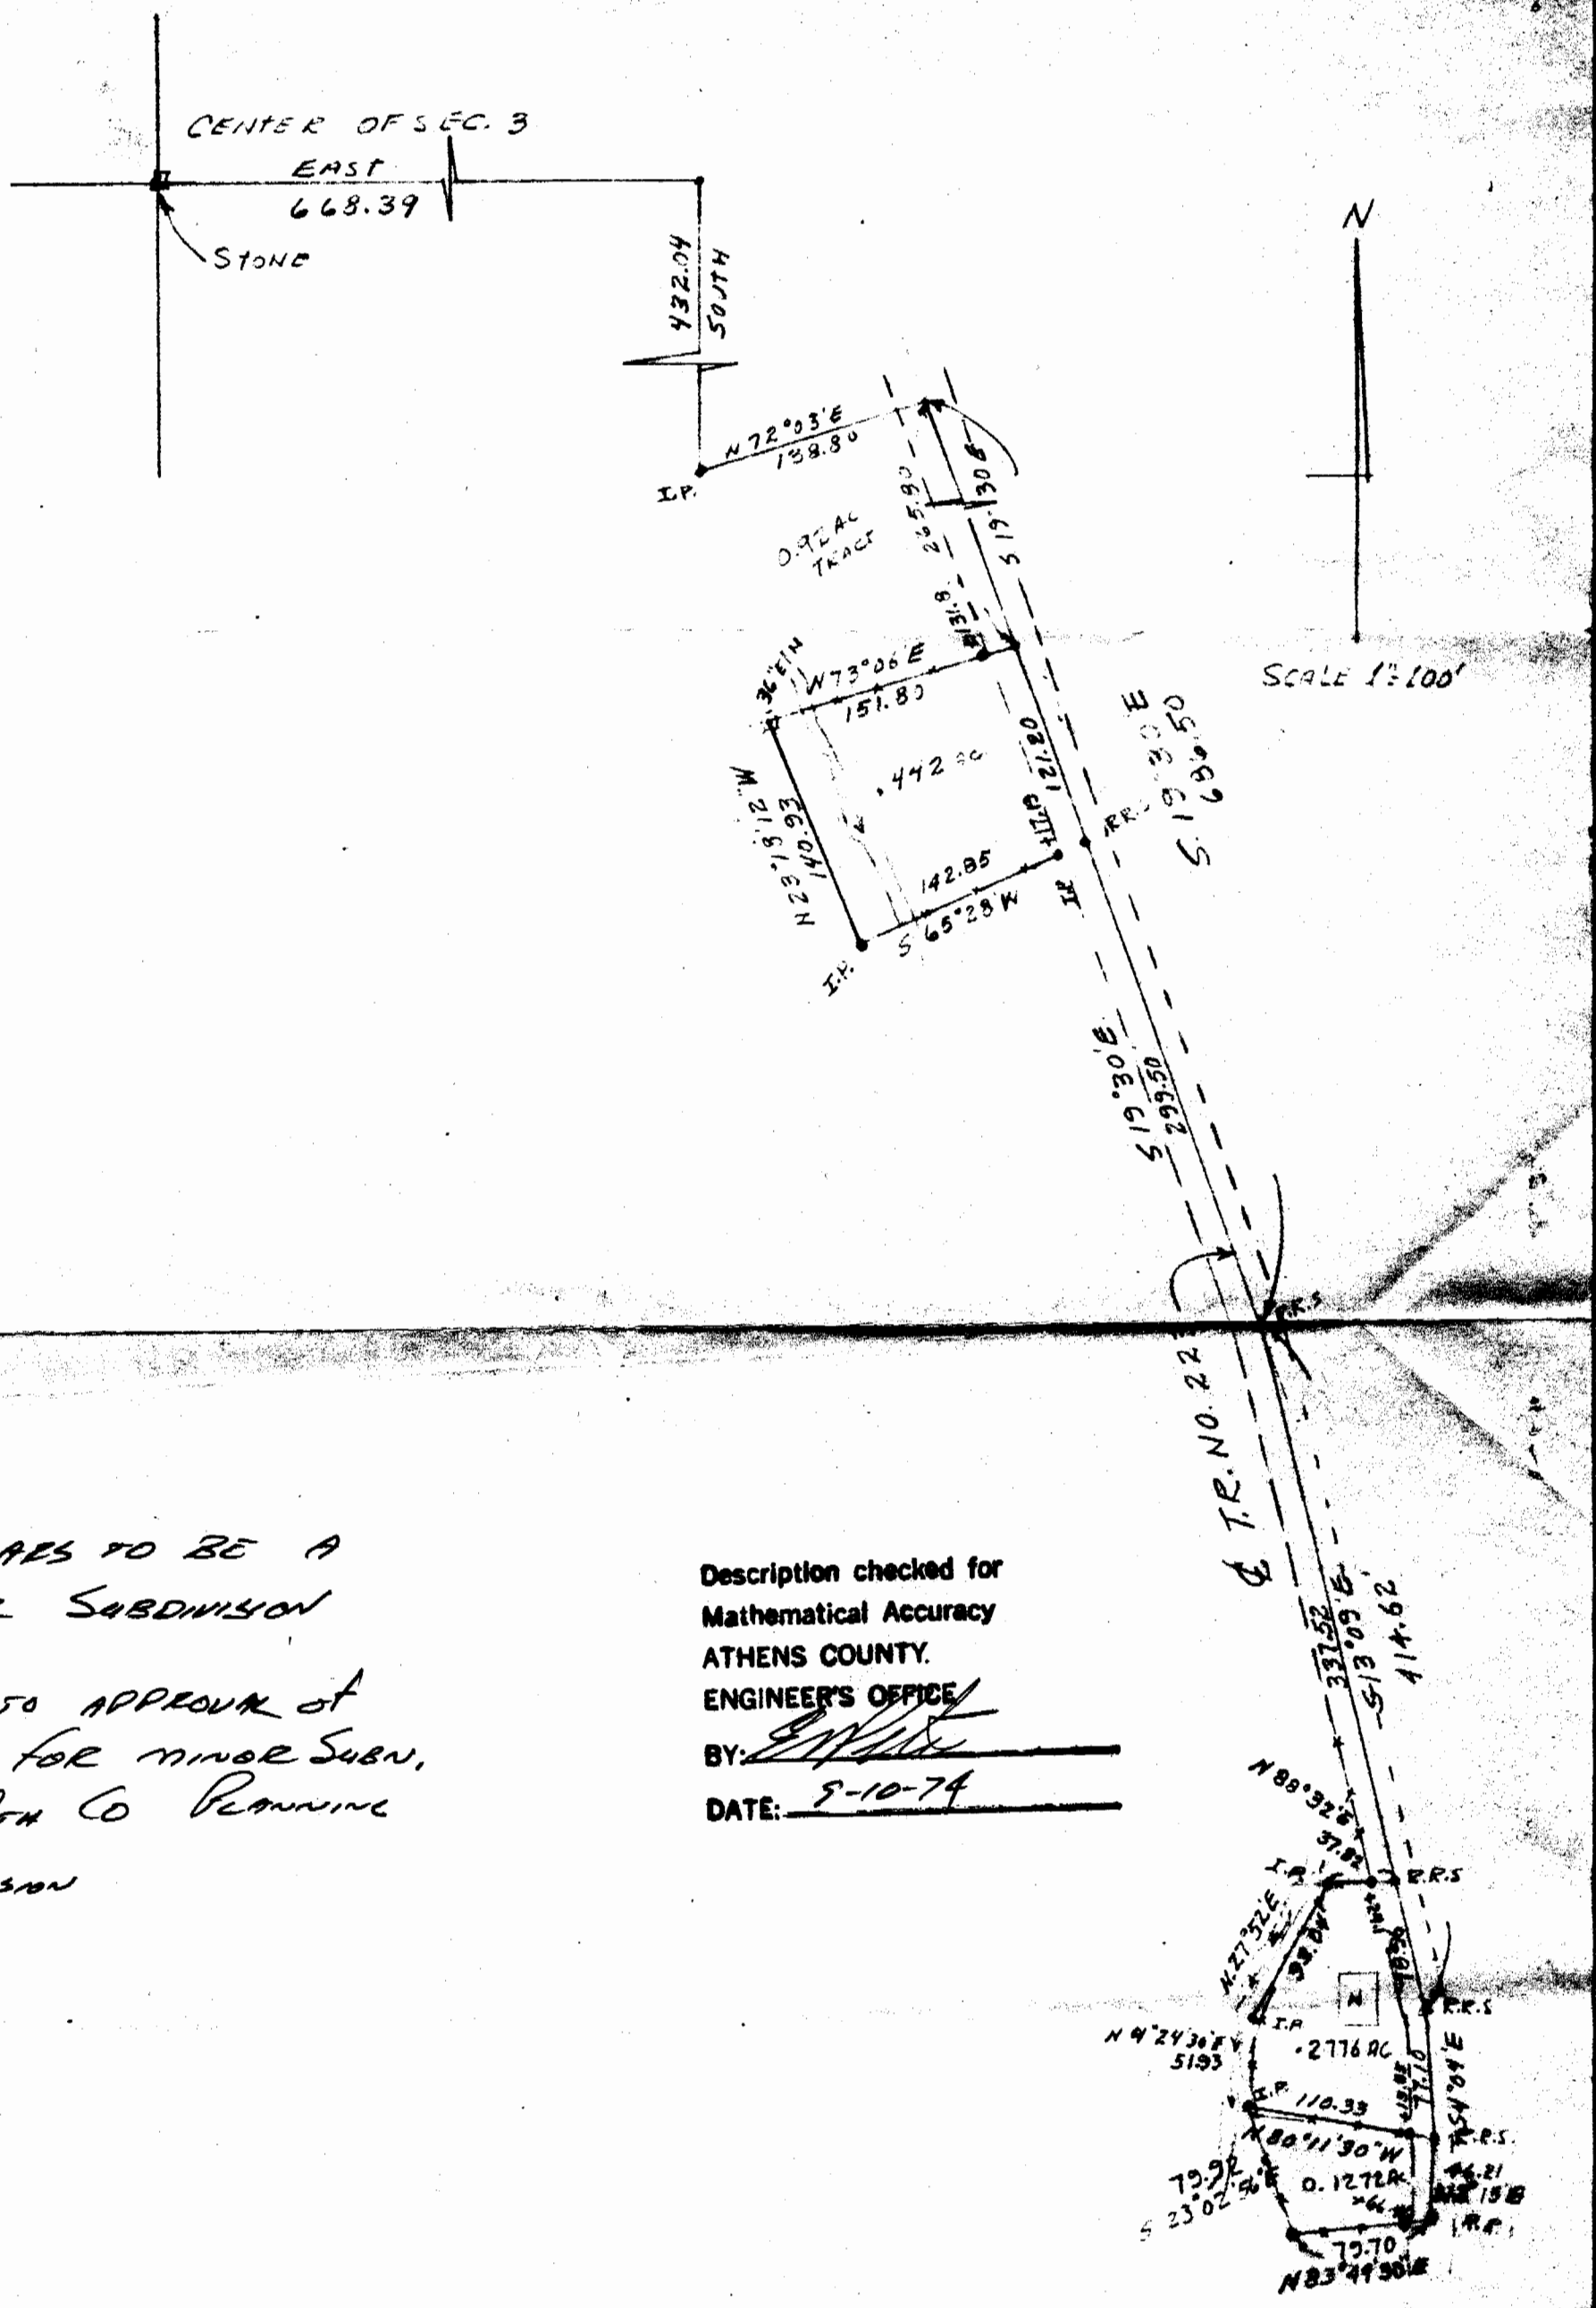

APPEARS TO BE A MINOR SUBDIVISION

SUBJ. TO APPROVAL OF APPL. FOR MINOR SUBN. BY ATH CO PLANNING COMMISSION

Description checked for Mathematical Accuracy
ATHENS COUNTY.
ENGINEER'S OFFICE
BY: E W Wells
DATE: 5-10-74

SURVEY OF A 0.442 ACRE TRACT & A 0.2776 ACRE TRACT & A 0.1272 ACRE TRACT
SEC. 3, T. 5, R. 13, CANAAN TWP, ATHENS COUNTY, OHIO
for CHARLES STOVER

SURVEYED JUNE 5, 1974, by HAROLD D. WHALEY
Harold D. Whaley
REG. SURV. NO. 4986

STATE OF OHIO
HAROLD D. WHALEY
REGISTERED
SURVEYOR

14

O.E. 25