

**DESCRIPTION OF
1.000 Acres**

Dave Williams
Parcel 5
Revised

Situated in Section 3, Town 5, Range 13, Canaan Township, Athens County Ohio, and being more particularly described as follows:

COMMENCING AT A POINT, said point being the Northwest Corner of the Northeast Quarter of Section 2; thence along the south line of Section 3, S 88°49'23" E 2547.40 feet to a stone found; thence leaving the section line N 10°10'38" E 121.61 feet to an iron pin found; thence N 11°01'02" W 581.25 feet to an iron pin set; thence N 10°36'24" E 372.51 feet to an iron pin set at

THE POINT OF BEGINNING OF THE TRACT HEREIN DESCRIBED;

thence N 53°16'32" W, 140.38 feet to an iron pin set;

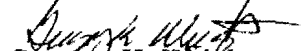
thence N 10°35'35" E, 283.68 feet to an iron pin set;

thence N 74°36'20" E, 140.32 feet to an iron pin found;

thence S 10°36'24" W, 406.99 feet to an iron pin set;

the point of beginning containing 1.000 acres.

Prior Deed Reference Volume 276, Page 1207 Official Records of Athens County.


Gregory K. Wright
Parcel5.doc

Description checked for
Mathematical Accuracy
ATHENS COUNTY
ENGINEER'S OFFICE

BY: S. Blausen
DATE: 5-3-02

153

Northwest Corner of
Northeast Quarter
Section 2

Donna Storer
276-1207 OR

- ⊙ = Iron Pin Found
- = Iron Pin Set
- = Stone Found



LINE TABLE		
LINE	BEARING	LENGTH
L1	N62°24'09"W	148.33'
L2	N74°36'20"E	140.32'
L3	S86°29'10"E	62.55'
L4	S25°38'33"E	160.60'
L5	S27°40'55"E	140.93'
L6	S53°16'32"E	140.38'
L7	S14°32'09"E	34.47'
L8	S14°32'10"E	228.87'
L9	S04°32'13"E	172.92'
L10	S23°02'13"E	228.36'
L11	S03°57'48"W	83.76'
L12	S03°57'47"W	134.70'
L13	S28°42'48"W	152.19'
L14	S28°42'47"W	70.89'
L15	S03°46'33"W	92.76'
L16	S00°33'52"E	90.00'
L17	S01°00'07"W	148.79'
L18	S29°39'08"E	165.42'
L19	N10°10'38"E	121.61'
L20	N11°01'02"E	97.32'

Section 2
Section 3

Parcel 2
270,901 sq. ft.
6.219 acres

Donna Storer
276-1207 OR

Parcel 3
196,919 sq. ft.
4.521 acres

Parcel 5
43,540 sq. ft.
1.000 acres

Parcel 1
101,675 sq. ft.
2.334 acres

Parcel 4
47,501 sq. ft.
1.090 acres

Parcel 6
397,286 sq. ft.
9.120 acres

David T. Williams
211-238

Parcel 7
35,388 sq. ft.
0.812 acres

Parcel 8
26,604 sq. ft.
0.611 acres

Michael Male
232-481 OR

Bertha Male
232-497

William Male
232-492

Donna Storer
276-1207 OR

Bernard Varner
241-338

Gregory Allen
Hoffman
257-779 OR

Sandra K. &
Raymond Thomas
240-472 OR



Description checked for
Horizontal Accuracy
ATHENS COUNTY
ENGINEERS OFFICE
S. Blausen
DATE: 8-26-02

Plat of Survey of 8 Parcels
Sited in Section 3, Town 5, Range 13, Canaan Township,
Athens County, Ohio.
Surveyed March 2002 for:
David T. Williams

Gregory K. Wright
Gregory K. Wright

Gregory K. Wright
Professional Engineer
Professional Surveyor

11684 Channingway Blvd
The Plains, Ohio 45780
740-797-4142
FAX 740-797-8623
Revised 5/2/02
P-00319

GRAPHIC SCALE



(IN FEET)
1 inch = 200 ft.

164