


GILSON'S SUBDIVISION

PART OF SECTION No. 33
CANAAN TOWNSHIP
ATHENS COUNTY, OHIO

*Map of the OK
should be prepared
7-2-24*

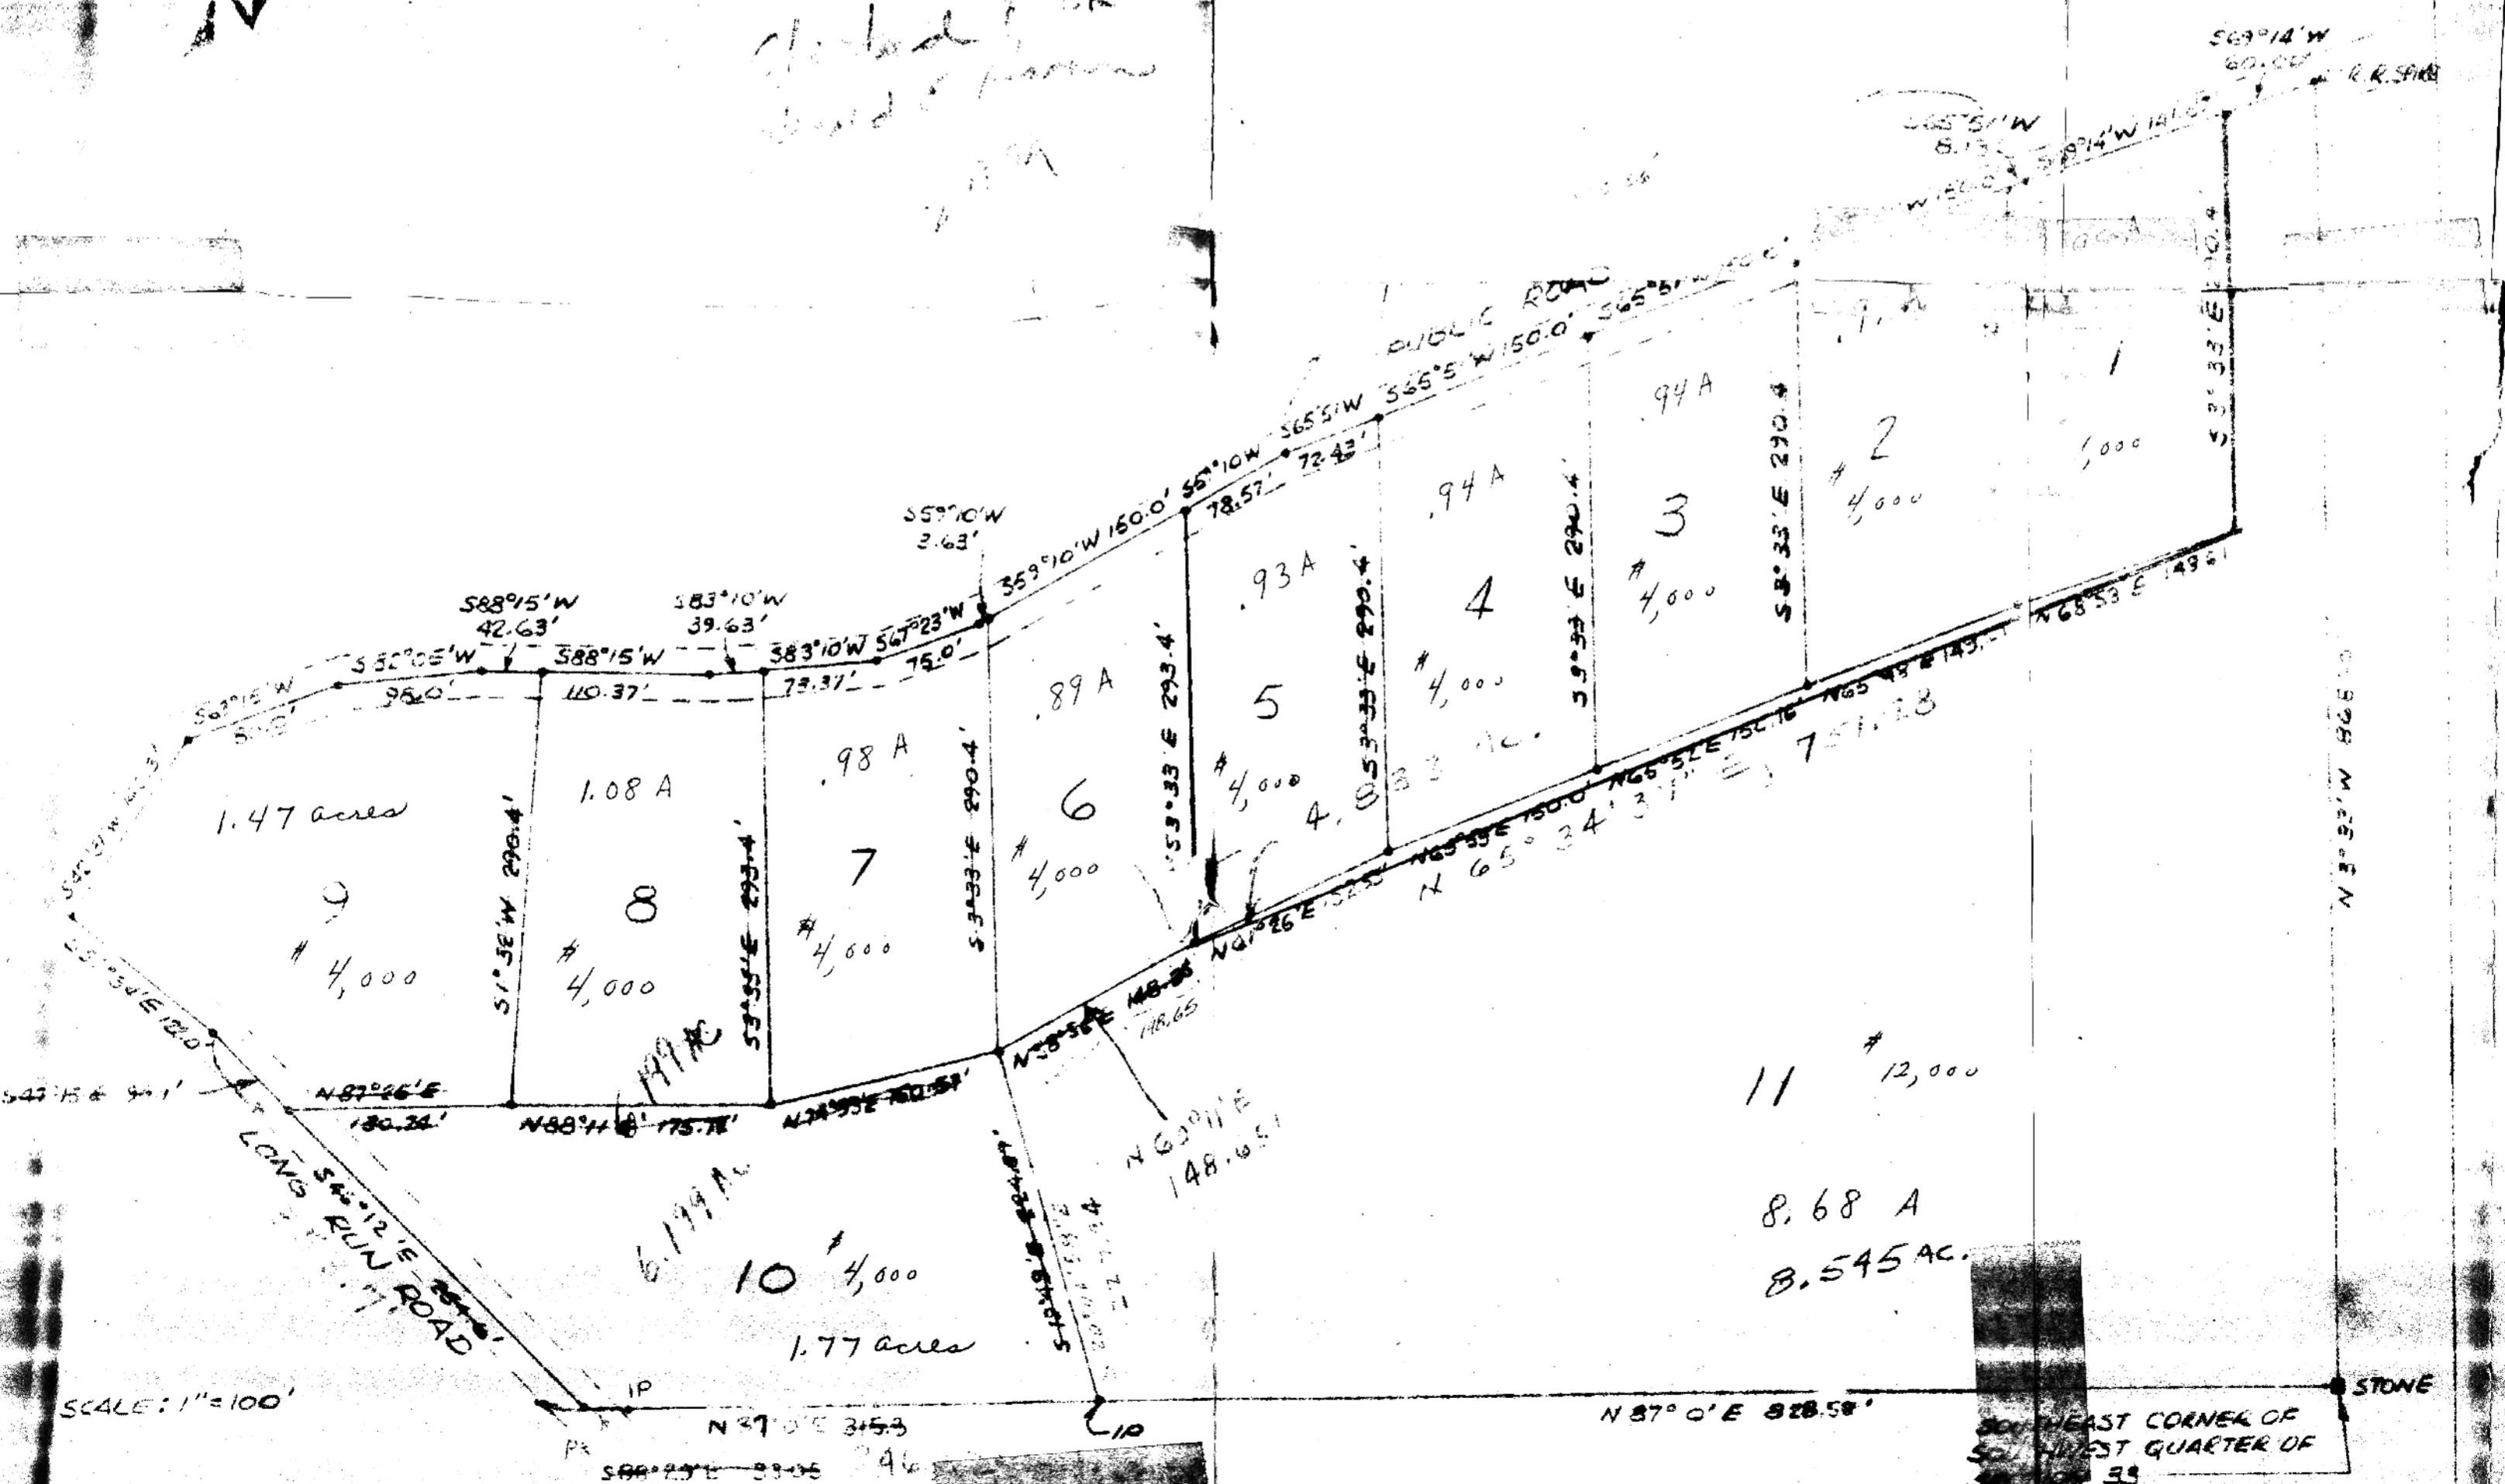

SCALE: 1" = 100'

49