


PLAT OF SURVEY OF 4 TRACTS:

- TRACT 1 = 5.000 AC.
- TRACT 2 = 5.0885 AC.
- TRACT 3 = 5.003 AC.
- TRACT 4 = 5.000 AC.

SITUATED IN SECTION 5, CANAAN TOWNSHIP, TOWN 5, RANGE 13, ATHENS COUNTY, OHIO.

PREPARED BY:  
SOUTHEASTERN LAND SURVEYS  
FOR: LEONARD LUCAS - AUGUST 8, 1991

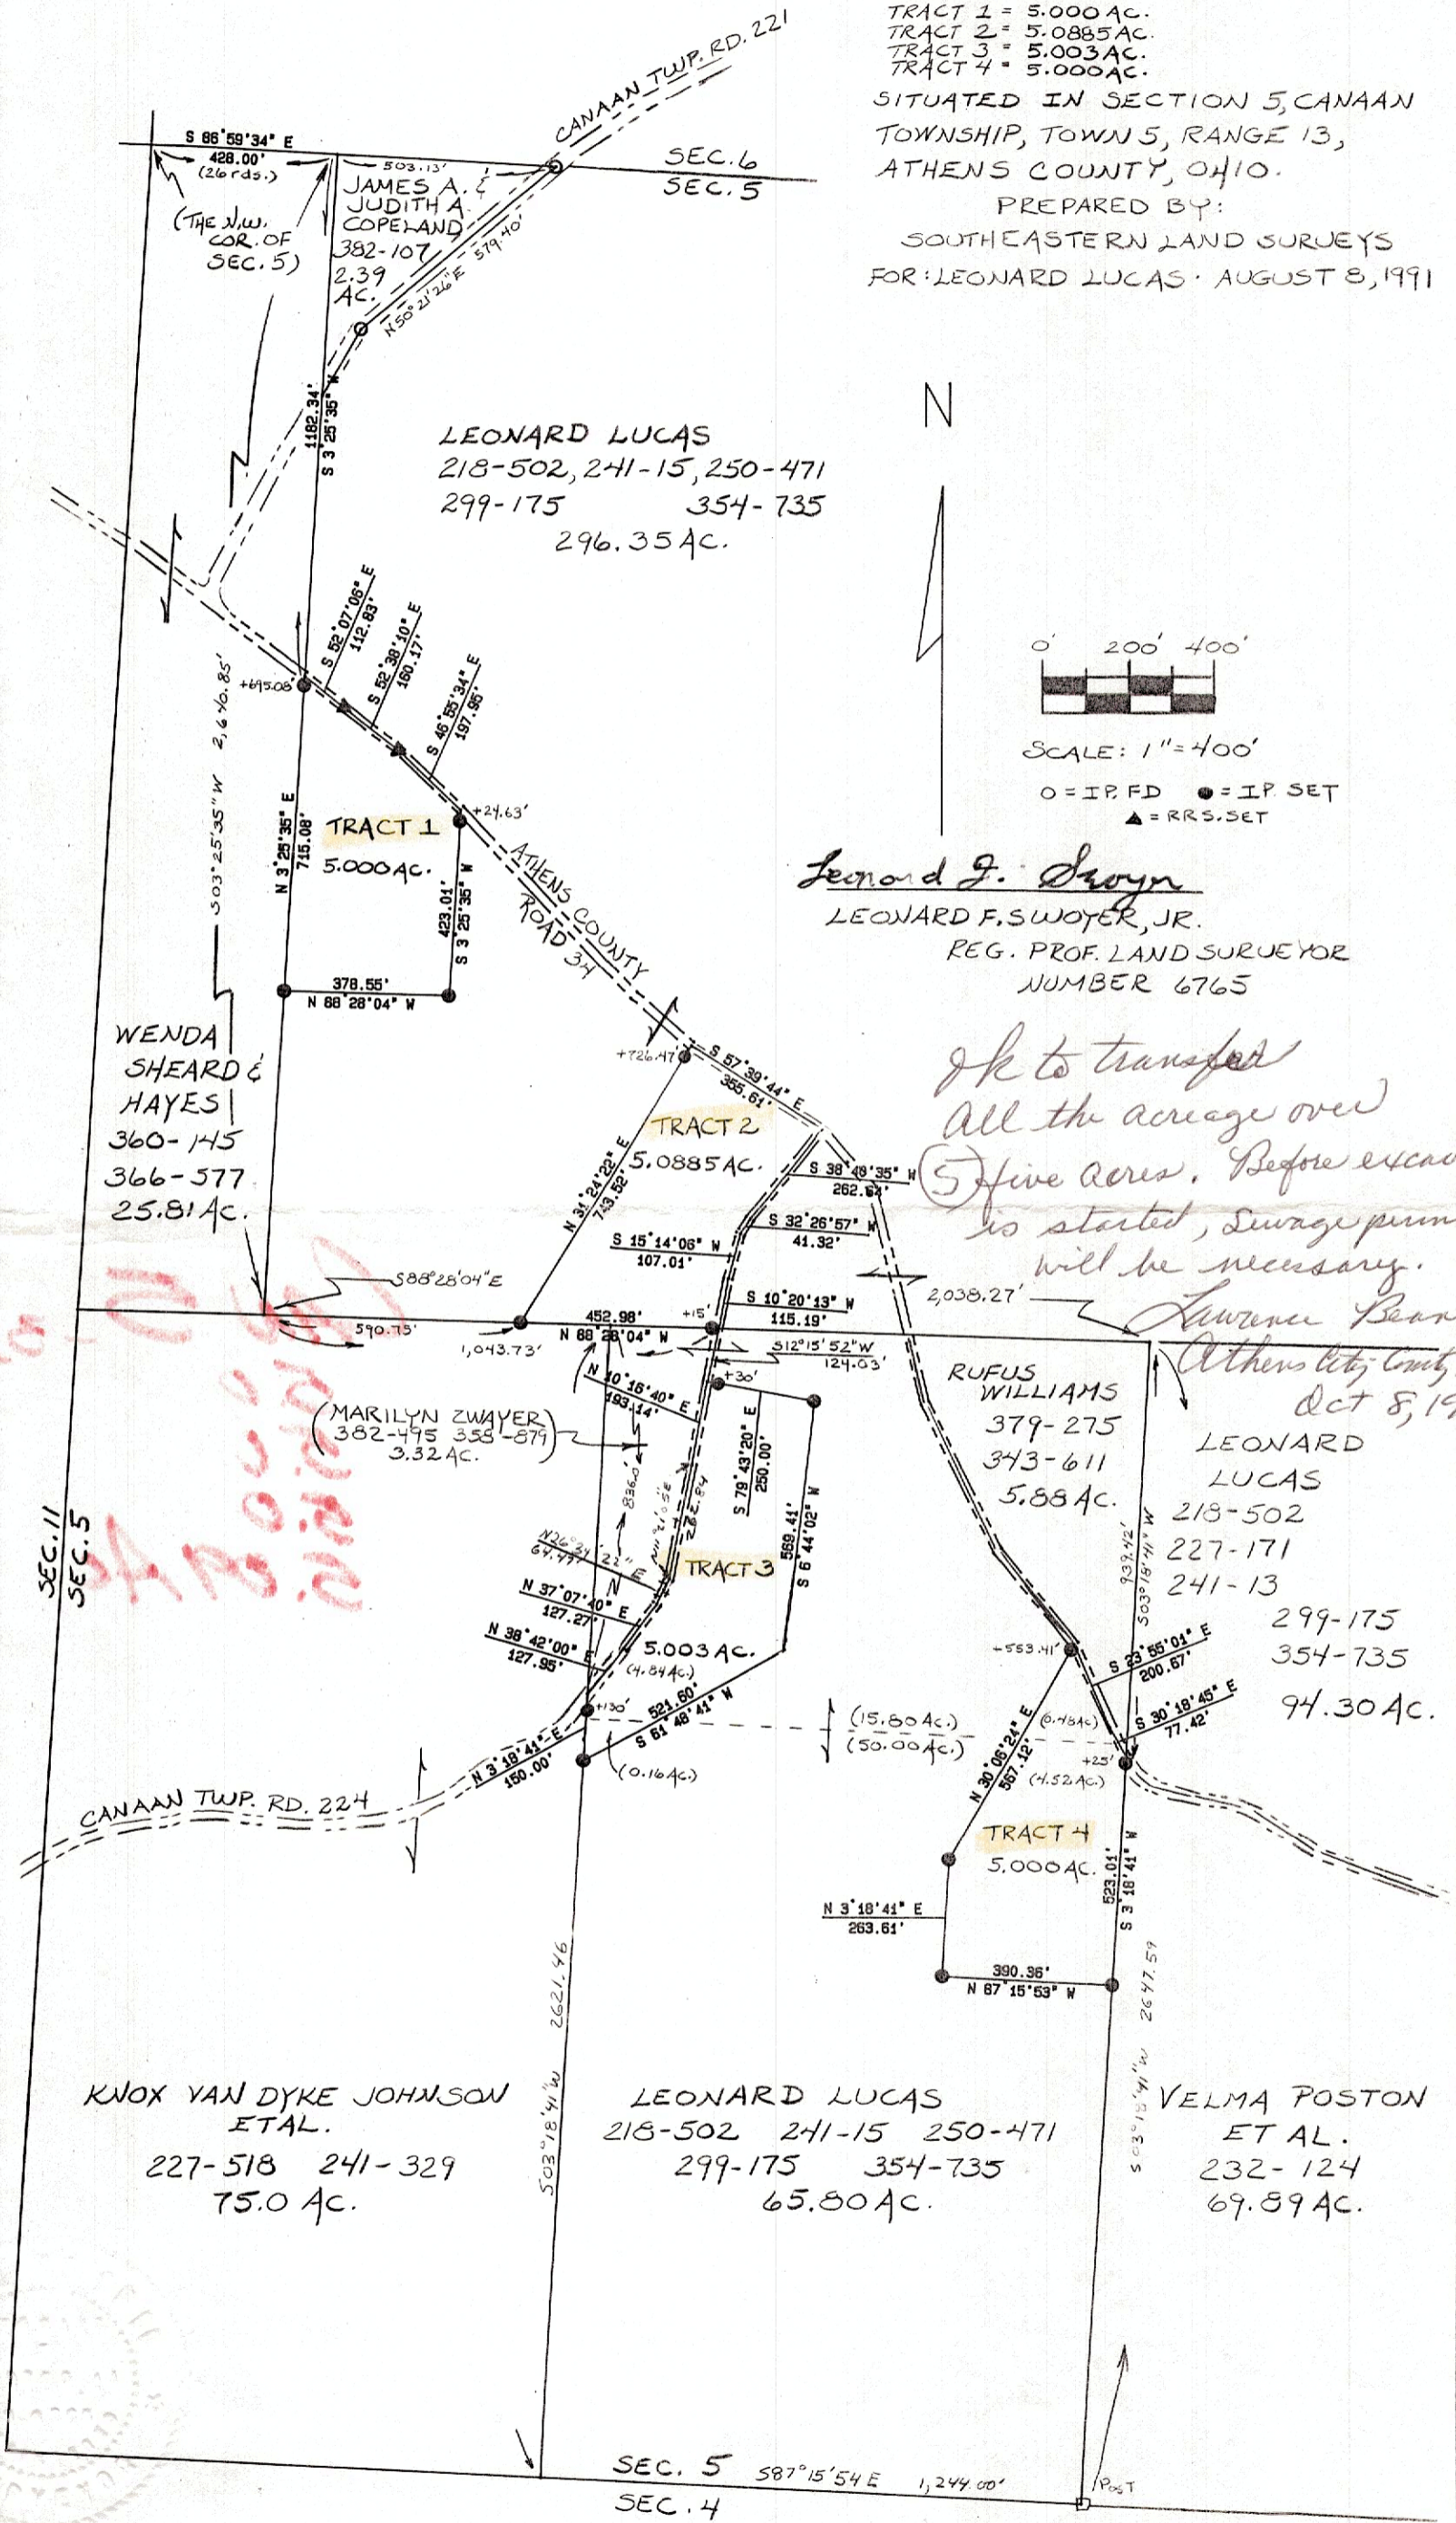

LEONARD LUCAS  
218-502, 241-15, 250-471  
299-175 354-735  
296.35 AC.

*Leonard J. Drayn*  
LEONARD F. SWOYER, JR.  
REG. PROF. LAND SURVEYOR  
NUMBER 6765

*ok to transfer  
all the acreage over  
(5) five acres. Before excavation  
is started, swage permits  
will be necessary.*

*Lawrence Bear R.S.  
Athens City Com. Health Dept.  
Oct 8, 1991*

RUFUS WILLIAMS  
379-275  
343-611  
5.88 AC.

LEONARD LUCAS  
218-502  
227-171  
241-13  
299-175  
354-735  
94.30 AC.

KNOX VAN DYKE JOHNSON  
ETAL.  
227-518 241-329  
75.0 AC.

LEONARD LUCAS  
218-502 241-15 250-471  
299-175 354-735  
65.80 AC.

VELMA POSTON  
ET AL.  
232-124  
69.89 AC.

*4.0*  
*Handwritten notes and scribbles*

