

REFERENCE

DEEDS AS LISTED
AMES TWP TAX MAP 13
CANAAN TWP TAX MAP 18
115.176 ACRE SURVEY BY
GREGORY WRIGHT 4-28-93
PREVIOUS SURVEYS
06-0104
07-0104
07-0801

PREPARED FOR
DONALD MORELAND

STATE OF OHIO
ATHENS COUNTY
CANAAN TOWNSHIP
TOWN 5 RANGE 13
SECTION 18
AMES TOWNSHIP
SECTION 13
TOWN 6 RANGE 13

DONALD MORELAND
166 - 371
368 - 1459 OH

DONALD MORELAND
115.18 Ac.
260 - 683 OR

DONALD MORELAND
ROBIN MORELAND
387 - 342 OR


ABBOTT SMITH
21.36 Ac.
296 - 1771 OR
19 - 489

PAUL M. FREEDMAN
408 - 747 OR
35 706 Ac.

PAUL M. FREEDMAN
409 - 2215 OR
34.59 Ac.

CALL TABLE

- L-1 S 10° 02' 13" E 30.00'
- L-2 S 16° 31' 18" E 30.19'
- L-3 S 30° 39' 22" E 30.27'
- L-4 S 44° 21' 25" E 30.17'
- L-5 S 47° 58' 19" E 30.03'
- L-6 S 44° 05' 00" E 30.01'
- L-7 S 46° 15' 41" E 30.06'
- L-8 S 35° 12' 05" E 31.01'
- L-9 S 23° 04' 58" E 30.03'
- L-10 S 27° 49' 01" E 30.02'
- L-11 S 29° 58' 47" E 30.00'
- L-12 S 01° 31' 53" E 30.63'

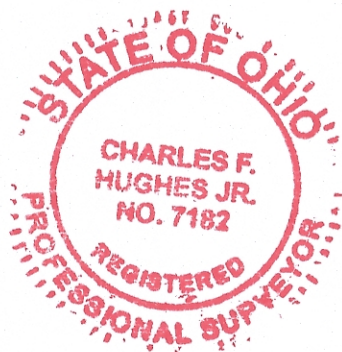


OK TO TRANSFER - NOT A
SUBDIVISION - TRANSFER
BETWEEN ADJOINING OWNERS -
1.4153 ac & 7.4497 ARE TO
BE HELD CONTINUOUSLY &
CONTIGUOUSLY WITH
ADJOINING PROPERTIES.

Bob Eichenberg
10-9-07

Description Checked for
Mathematical Accuracy
Athens County
ENGINEER'S OFFICE
BY: *S. Blause*
DATE: 7-18-07

CHARLES F. HUGHES JR. PROFESSIONAL SURVEYOR	
SCALE: 1" = 100'	APPROVED BY: JLH
DATE:	REVISED:
P.O. BOX 216, MINERAL WELLS, WV 26150	
DRAWING NUMBER: 1-304-489-9640	

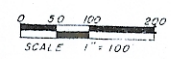

Chl 716/97 9-10-2007
CHARLES F. HUGHES, JR.
P.S. 7182