


CAW 26, 27

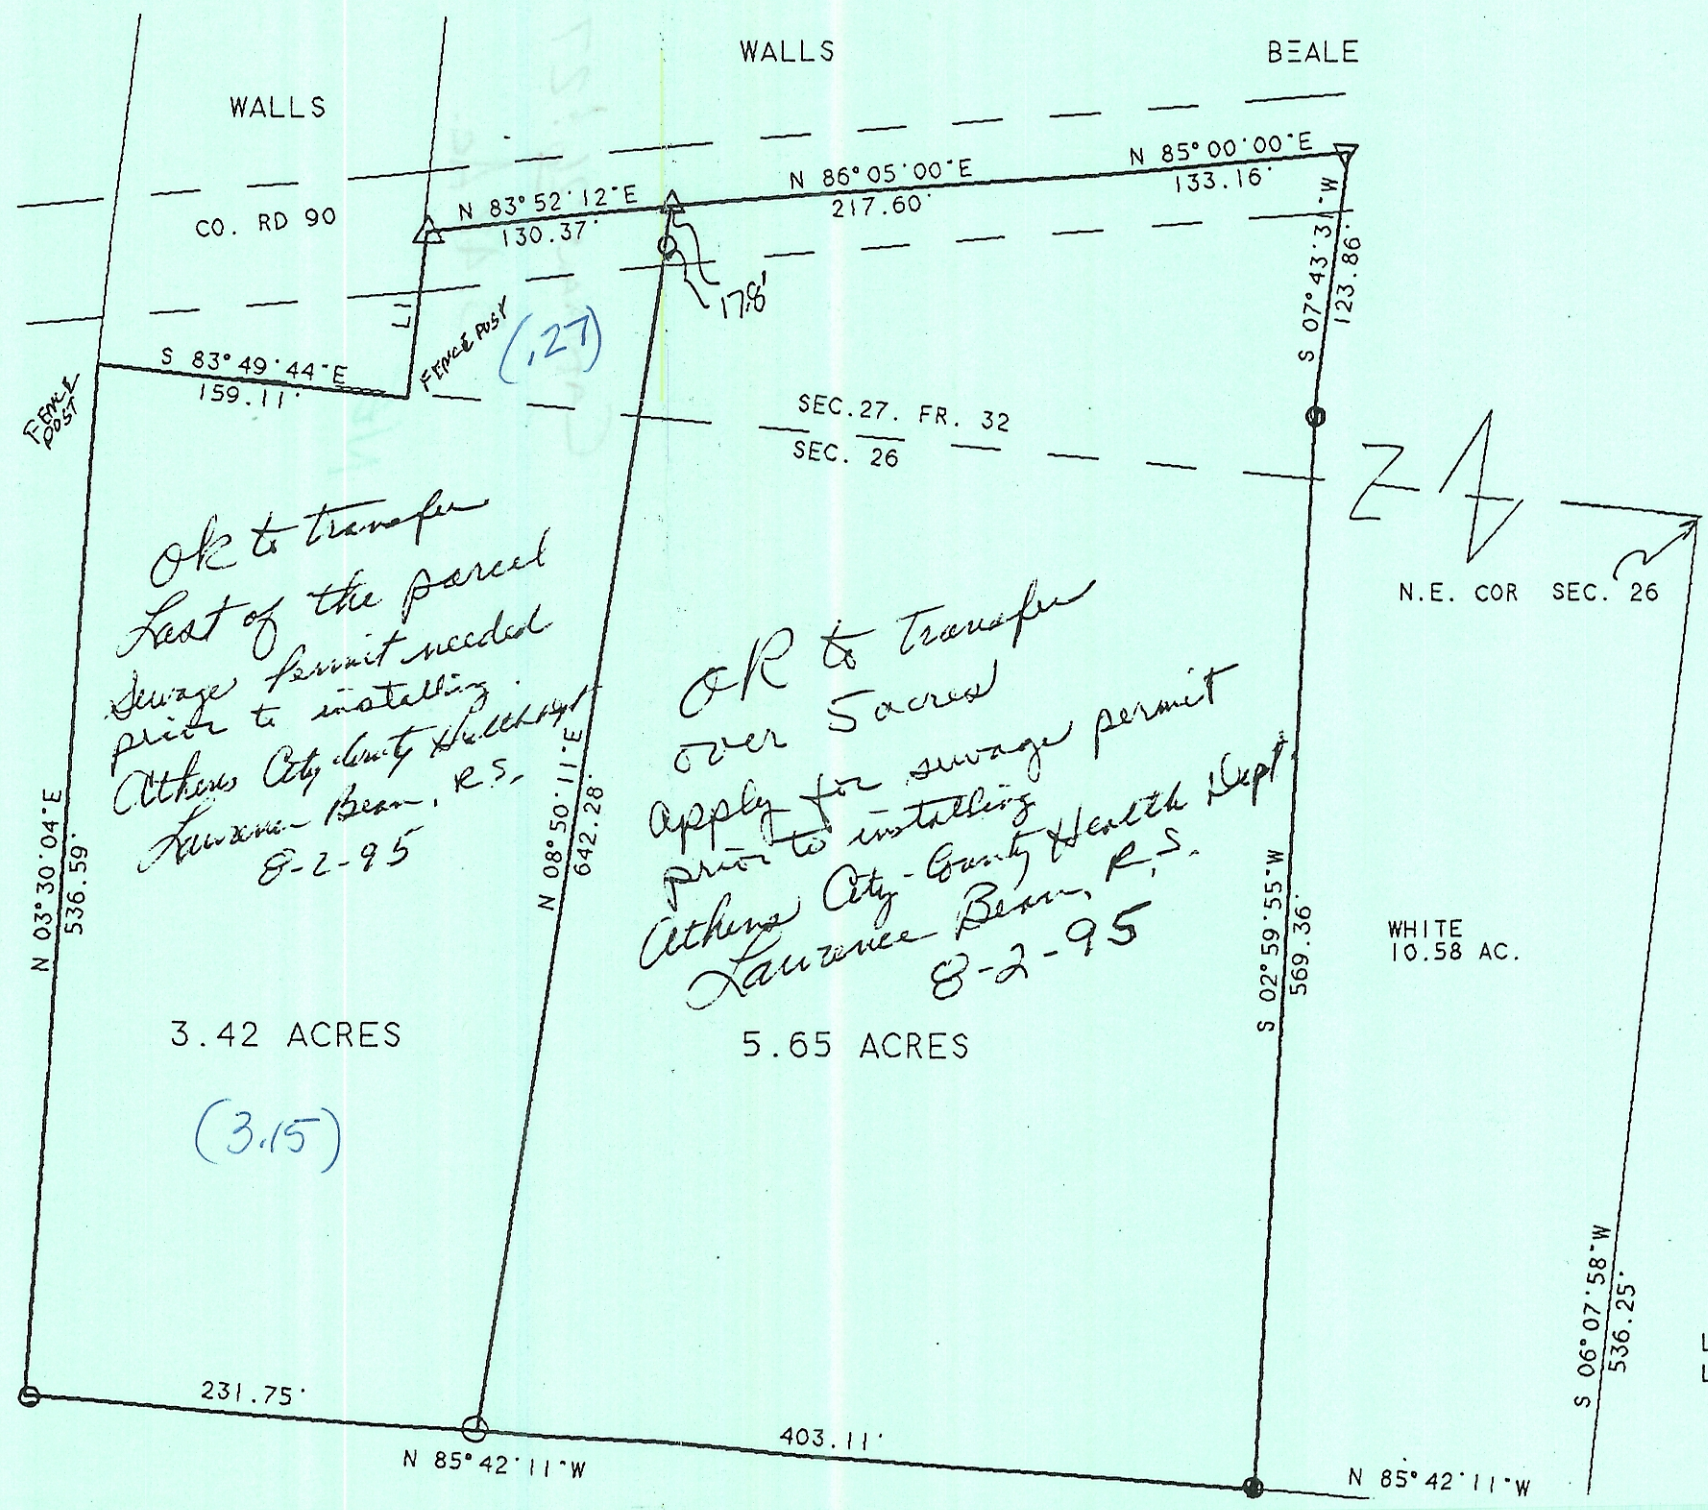

- O = IRON P
 - ⊙ = EXISTI
 - △ = R.R.S
 - ▽ = P.K. N
- SCALE 1 IN

LINE BEAR IN

L.I N 06° 10