


Description Checked for
Mathematical Accuracy
Athens County
ENGINEER'S OFFICE
BY: *S. Mause*
DATE: *9-6-07*

**SURVEY OF A 105.67 ACRE TRACT
IN SECTION 16 AND 17, T.5, R.12,
CARTHAGE TOWNSHIP
ATHENS COUNTY, OHIO
SURVEYED AUGUST 2007**

BY: *John M. Branner*
**JOHN M. BRANNER P.S. 6805
12500 N. PEACH RIDGE ROAD
ATHENS, OHIO 45701
(740) 592-5778**

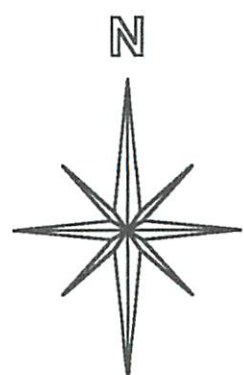

| Line | Bearing | Distance |
|------|--------------|----------|
| 1 | S 59°47'33"E | 155.87' |
| 2 | N 85°26'04"E | 247.55' |
| 3 | N 67°10'59"E | 275.32' |
| 4 | N 9°49'13"W | 121.54' |
| 5 | N 73°58'01"E | 205.27' |
| 6 | S 38°27'01"E | 32.36' |
| 7 | S 49°19'27"W | 58.74' |
| 8 | S 40°40'33"E | 100.00' |
| 9 | N 49°19'27"E | 54.86' |
| 10 | S 38°27'01"E | 125.09' |
| 11 | S 30°09'57"E | 63.33' |
| 12 | S 30°09'57"E | 103.68' |
| 13 | S 43°11'29"E | 170.01' |



SCALE 1 INCH = 400 FEET
○ = IRON PIN SET
● = IRON PIN FD.
ASSUMED BEARINGS
TO BE USED TO DENOTE
INTERIOR ANGLE ONLY