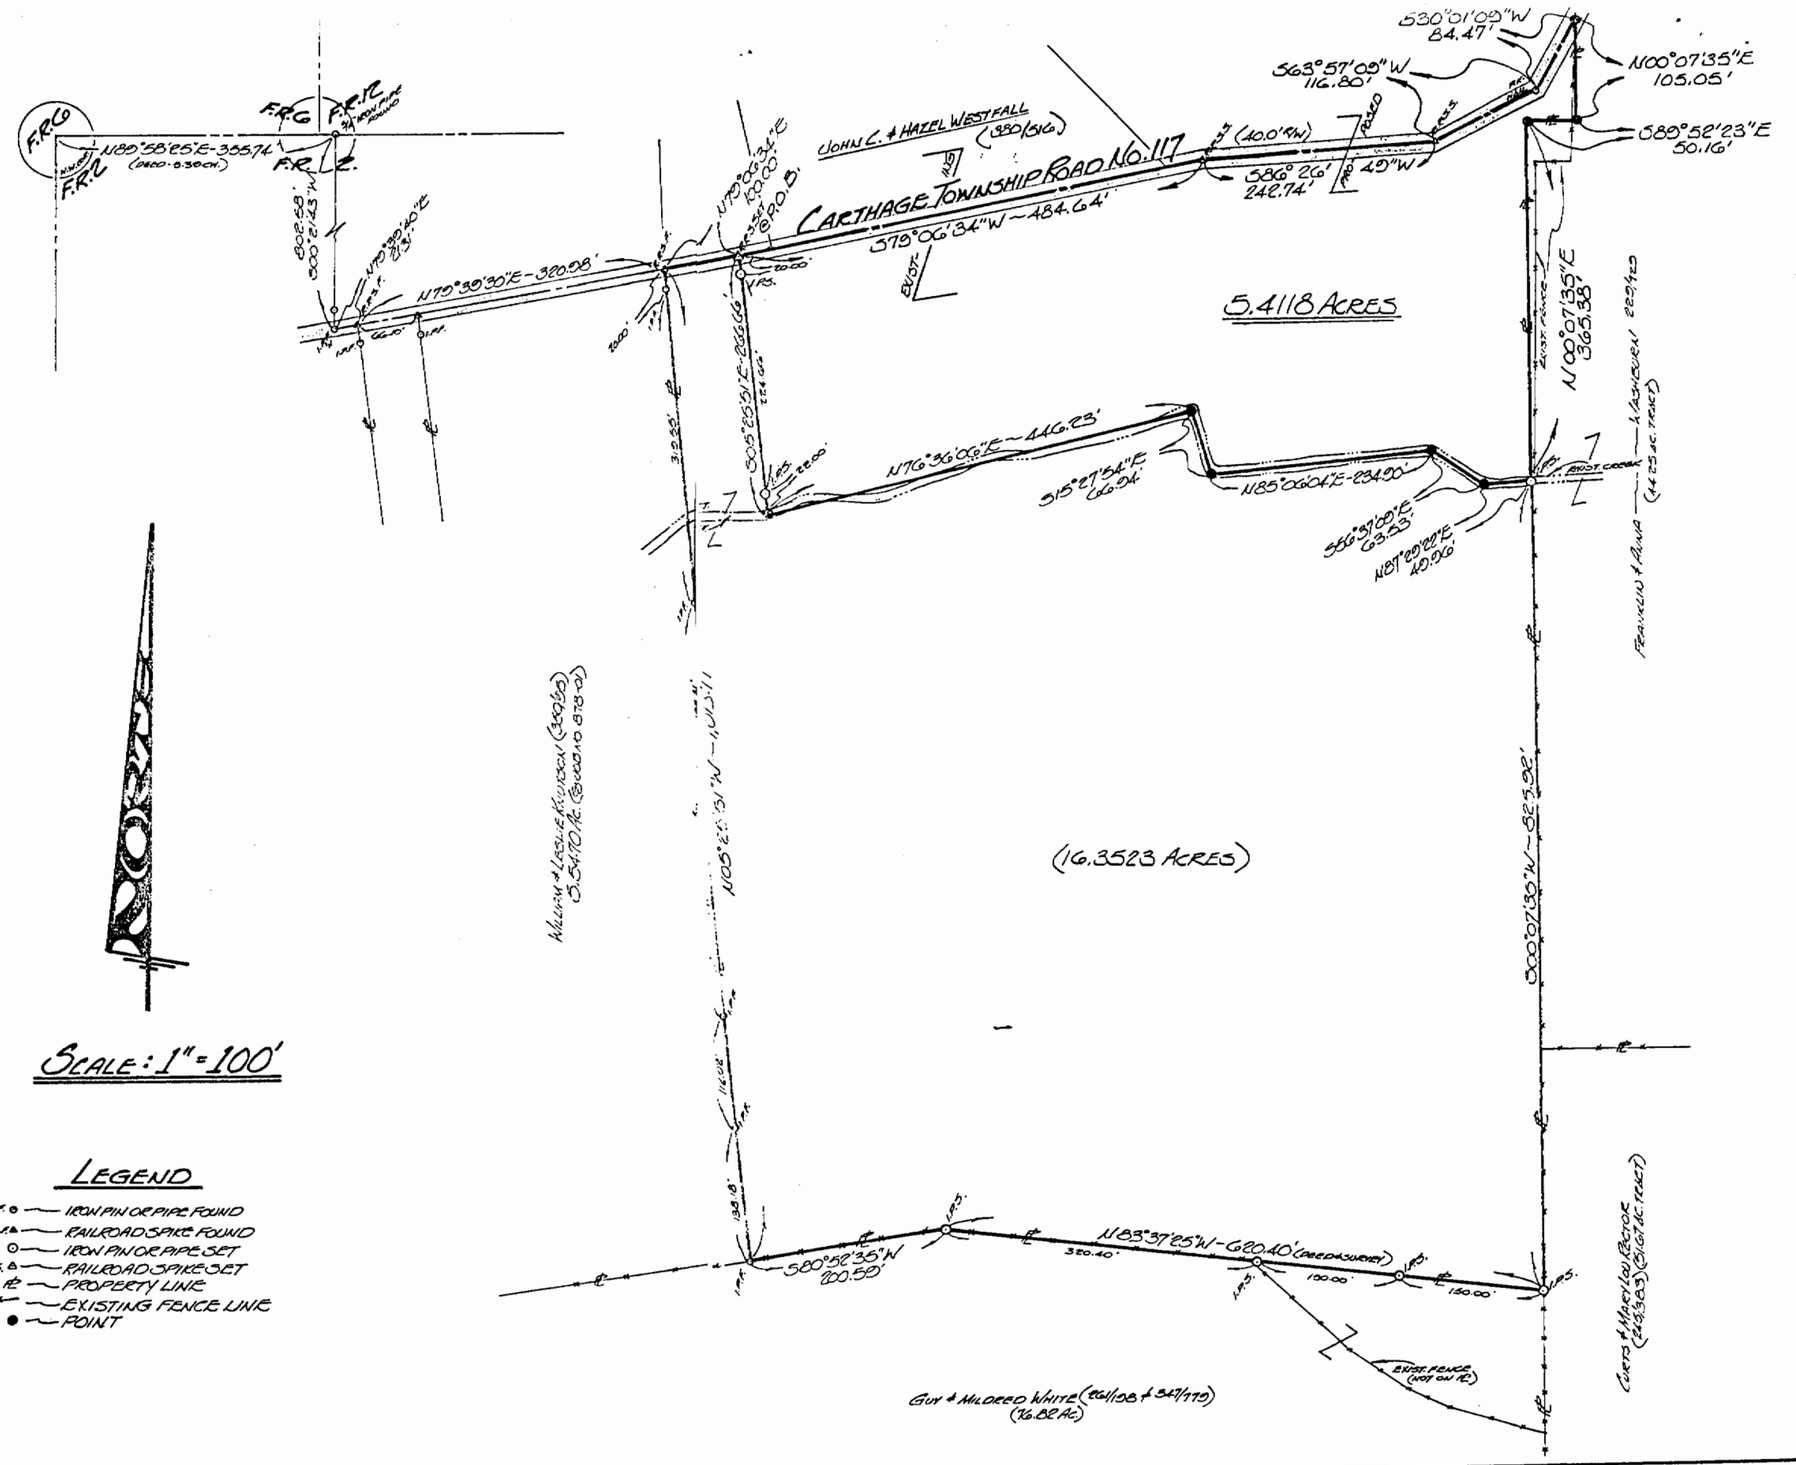

SCALE: 1" = 100'

LEGEND

- I.P.F. ○ — IRON PIN OR PIPE FOUND
- R.R.S.F. △ — RAILROAD SPIKE FOUND
- I.P.S. ○ — IRON PIN OR PIPE SET
- R.R.S.S. △ — RAILROAD SPIKE SET
- ℄ — PROPERTY LINE
- — EXISTING FENCE LINE
- ● — POINT

PROFESSIONAL LAND SURVEYORS
- OIL WELL PERMITTING
- LOTS & FARM SURVEYS
- SUB-DIVISIONS
- LAND PLANNING
- CONSTRUCTION

SEYMOUR & ASSOCIATES
69 S. MARKET ST.
P.O. Box 624
Logan, Ohio 43138
385-5954

STATE OF OHIO — GERALD W. BAYHA — 6-6139 — PROFESSIONAL SURVEYOR

FOR: JOHN C. & HAZEL G. WESTFALL
WHITE GUYS — 6.1 — BOX NO. 50 — 22122 VARNER RD. — ILLE, OHIO — 45735

BY: GERALD W. BAYHA, P.S.
REGISTERED PROFESSIONAL SURVEYOR 16-5-6139

PLAT OF SURVEY

OF A 16.3523 ACRE TRACT SITUATE IN THE F.R.C. (SECTION 8) — TOWN 5 — RANGE 12 — CARTHAGE TWP. — ATHENS COUNTY — STATE OF OHIO — U.S.A.

Drawn	Checked	Revisions	Date	Job No.	Sheet No.
GB	GB	11-22-94: CD 5.4118 Ac. TRACT ADDED.	26 SEPT 1979	#979-03	1 / 1

SURVEY I.A.

136

137