

LEGEND

- △ - 5/8" x 30" IRON PIN SET w/ID. CAP STAMPED "G.W. DAYHA - P.S. 6139"
- ▲ - 3/4" ID. x 5' Long - SCHED. 40 WHITE PVC POST SET ON PL'S
- ⊙ - MAGNAIL SET
- - IRON PIN FOUND (5/8" if size not noted)
- ⊖ - IRON PIPE FOUND (ID. Size Noted)
- ⊗ - IRON PIN FOUND w/ID. CAP STAMPED "HIGHLAND S-7561"
- ▲ - IRON PIN FOUND w/ID. CAP STAMPED "PRICE - P.S. 8362"
- ⊞ - STONE FOUND w/'X' FOUND
- - STONE FOUND (No 'X')
- ⊕ - 5' LONG MAGNAIL SET
- - POINT
- ⊕ - POWER POLE
- (D) - DEED DIST. (S) - THIS SURVEY DIST.

REFERENCES

DEEDS AS NOTED COUNTY TAX MAPS & AERIALS PREVIOUS SURVEYS THE SLATER-POSTON ADDTN. TO CHAUNCEY, OHIO as recorded in Plat Book 4/Fair, and presently in Envelopes 171-D & 172-A IN THE ATHENS CO. RECORDER'S OFFICE EXISTING MONUMENTS



NOTE: THE BEARINGS USED HEREON ARE BASED ON THE NORTH R/W LINE OF ELM STREET AS BEARING: N 73°29'10" E, AND ARE ONLY FOR THE DETERMINATION OF RELATIVE ANGLES.

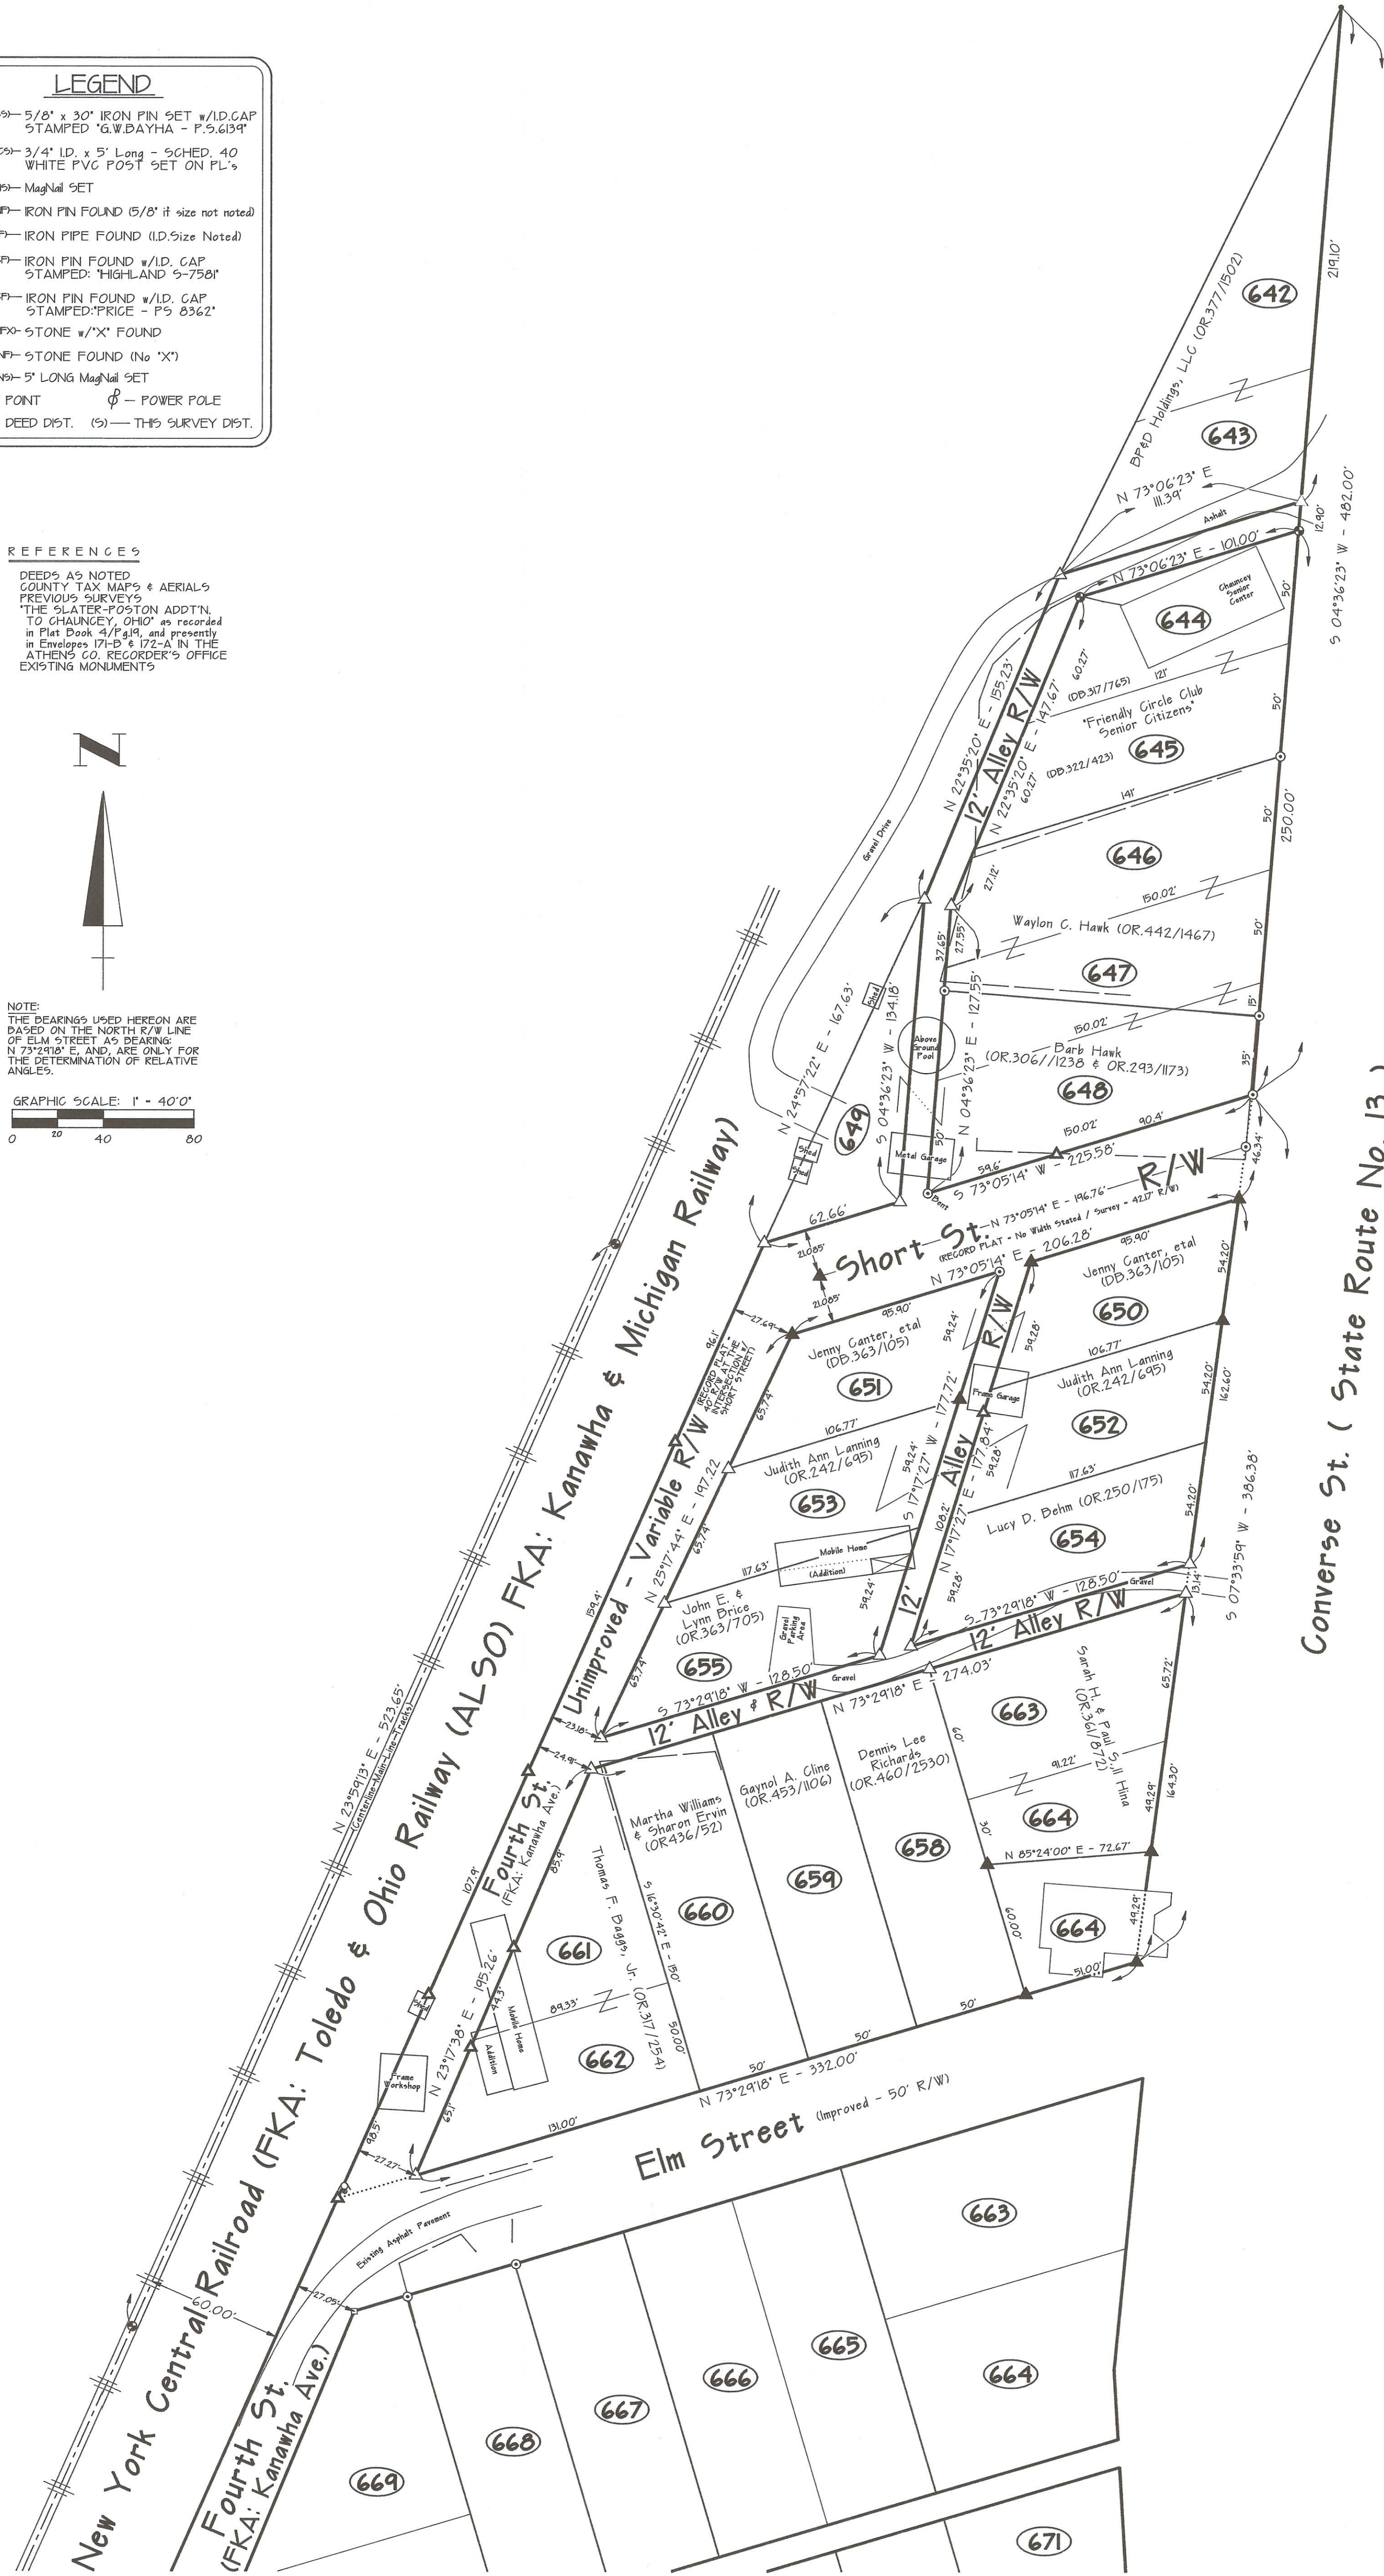
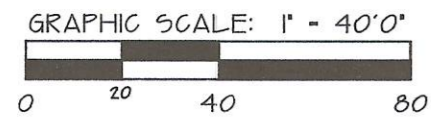


EXHIBIT "A"

EXHIBIT "A"

MATHEMATICAL CLOSURE APPROVAL
Mathematically approved this N/A day of N/A, N/A.

NOT REQUIRED
Athens County Engineer's Office

CERTIFICATE OF SURVEYOR
I hereby certify that the foregoing is a true and correct copy of the results of a survey made by me, with the field work being completed on OCTOBER 14, 2011, and that all monuments called for hereon are set as shown.

Dy: *Gerald W. Dayha*
Gerald W. Dayha, P.S.
Ohio Registered Professional Surveyor No. 5-6139

20120003841
Filed for Record in
ATHENS COUNTY, OHIO
JESSICA HARRIS, RECORDER
07-16-2012 AT 01:40 pm.
PLAT 86.40
ENN 571A

SHEET	REVISIONS
1	

PLAT OF SURVEY

Of Various Partially Improved & Unimproved Public Rights-of-Way Situate In Section 20, T.10.N., R.14.W., Village of Chauncey, Dover Township, Athens County, State of Ohio, U.S.A.



Gerald W. Dayha, P.S.
Registered Professional Surveyor No. 5-6139
10916 Pleasanton Road
Athens, OH 45701-9557
Voice: 740.593.5686 Fax: 740.594.7361
E-mail: jdayha@hughes.net

SURVEYED FOR: Village of Chauncey, c/o Jeff Traugh - Village Administrator, P.O. Box 227, Chauncey, OH - 45719