


1	2	3	4	5	6	7	8	9
Kinnear Keith 2019 Kinnear	Yinger Steve 2017 Yinger	W			Roman Roman	Joseph Roman	May May	May May
Linda 2011 Kinnear	Kathy Yinger					Roman Roman	May May	Michael G. McAure
Chris Kinnear			Aaron Dexter			Roman Roman	Quinn Quinn	Loretta Ann McAure
11	12	13	14	15	16	17	18	19
Newman			Melvin Lewis 2013	Melvin Lewis 2015		Karen V. Kantner	Randy Lec 2012 Bartow	
Newman			Bertha Lewis	Stephanie Dianthous Middletown		Rachel Kantner	Cary Bartow	
Newman				Jan 2017 Maccombs		James Keith 2017 Palmer	Alice Bartow	
Newman				Rheta Maccombs		Juan Palmer	Bartow	
20	21	22	23	24	25	26	27	28
29	30	31	32	33	34	35	36	37
38	39	40	41	42	43	44	45	46
47	48	49	50	51	52	53	54	55
Cartha Cramer			John Johnson	Virgil Crandy	Timothy Koker 2015		Kin Dexter 2016	12-13-12 Lehman
			Brenda S Johnson	Carol Crandy				Jalie Lehman
			Kirk Crandy			Long	Greg Warren	Honore E Onoi
			Tanya Crandy			Long	Sheila Warren	Carolyn K Onoi 2018
								Bertha Shanklin 2013
								Marilyn 2014 Shanklin
							Dow McVEY	Glenn A 2014 Warren
							Bree McVEY 2019	Lulu Belle 2015 Warren
56	57	58	59	60	61	62	63	64
Arthur Lambert		Suzanne Dietrich	RAG Dietrich			DANNY KOSKA	Carey Nicola	2014 Larry Williams
Marilyn Lambert		Suzanne Dietrich	RAG Dietrich			Phillips KOSKA	Carey Nicola	Mary Williams 2013
Rhoten	Rhoten	Suzanne Dietrich	RAG Dietrich	Ed Johnson	William 2016 Carsey	Figgins	Edward Figgins	Hold J.S.
Rhoten	Rhoten	Suzanne Dietrich	RAG Dietrich	Hope Johnson	Delilah Carsey	Figgins	Figgins	Hold

Road

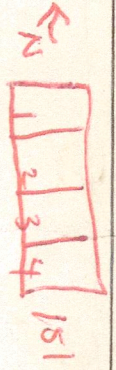

120'

216 Graves

90'

ROAD