

M E S S A G E

R E P L Y

TO Mr. Ernie Peters
County Engineer's Office
555 East State Street
Athens, Ohio 45701

DATE 10-24-74

DATE October 22, 1974

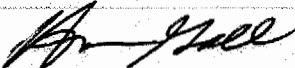
Re: Property of Theodore and
Flora Kelzenberg

Dear Ernie:

Enclosed please find a copy of
a survey containing .0543 acre which I
would appreciate your going over and
returning to me. Thank you for your
anticipated help in this regard. If
you have any questions, feel free to
contact me.

Very truly yours,

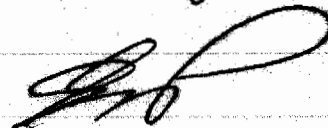
WALKER, MOLLICA & GALL CO., L.P.A.


Homer B. Gall, Jr.

HBG/jac
Encl.

SIGNED

SIGNED

Homer;
Enclosed you will
find the approved
survey description


257 256 255 225 224 223 222 221

MAY AVENUE

ADDITION TO THE
TOWN OF CHAUNCEY
P.B. 7, P. 30

252

254

Lot 814

Lot 815

816

817

818

253

50' 00" N
21' 50" E

118' 50" N - 113' 00"

BENT I.P.F.

12' ALLEY

58' 53" E - 113' 08"

100° 25' 13" E
20' 52"

BESSIE NYE LONG 189/113

THEODORE & FLORA
KELZENBERG
222/173

NORTH

Description checked for
Mathematical Accuracy

ATHENS COUNTY

E. G. NEER'S OFFICE

DATE: 10-24-74

Drawn by Rev:

SURVEYED FOR: MR. FRED CRABTREE

SCALE: 1" = 50'



PLAT OF SURVEY

BEING A 0.0543 AC. NON-BUILDING SITE
SITUATE IN SECTION 20, T10N, R14W, DOVER
TWP., VL. OF CHAUNCEY, ATHENS CO., OHIO.

By: **GERALD W. BAYHA, P.S.**
Route No. 1, Box No. 43-C,
Athens, Ohio - 45701
G14-592-4523
REGISTERED PROFESSIONAL SURVEYOR No. 5-6139

73

Gerald W. Bayha, P.S.

DATE: 15 OCT 1974

Job No. 374-01

See 20 Box

