


PLAT OF
FAIRVIEW

ENVELOPE: 182A
FAIRVIEW - PLAT OF

SITUATED IN FRACTION NO 12 O.C.P. TWP U

SCALE - 1 in = 100 feet ATHENS CO, O

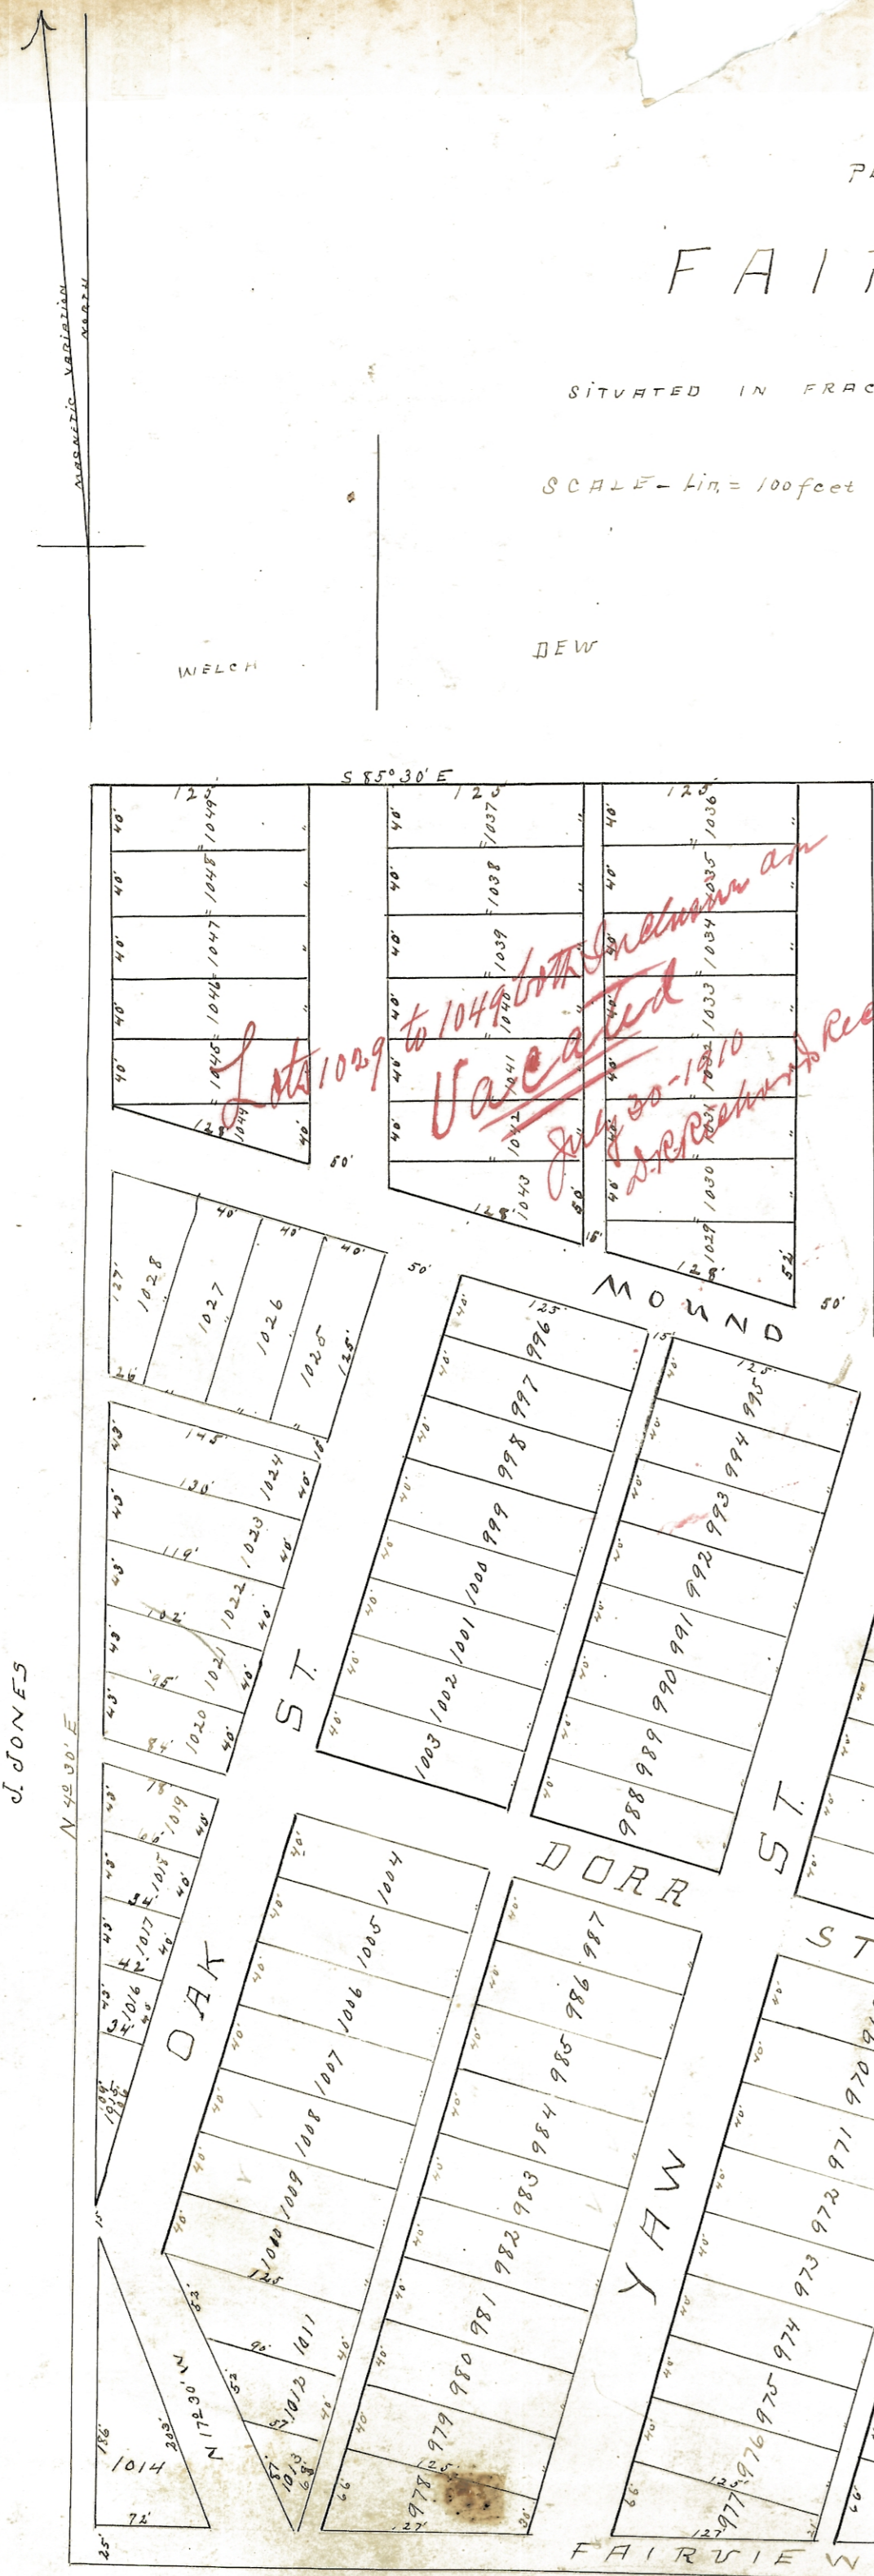

Know all men by these presents:
That James V. Stocklein, the owner of the lands delineated and described as the within plat, do hereby acknowledge the making of the same to be my voluntary act and deed and I do hereby dedicate the streets and alleys shown thereon to and for public use forever. Reserving and excepting however therefrom all of the coal and other minerals underlying said lots, streets and alleys with the right to mine and remove the same and the right to remove coal and other minerals from adjoining and adjacent premises through entries in mines in or under said lots, streets and alleys.
Witness my hand this 20th day of October 1903.
James V. Stocklein

I hereby certify that this is a true plat of the village of Fairview and situated in fraction no. 12 O.C.P. Trimble township, Athens Co. Ohio, as surveyed by me Dec. 1901.
J. A. Richards
Surveyor.

The State of Ohio, Athens County.
Be it remembered that on this 20th day of October 1903, before me the undersigned a Notary Public within and for said county personally came James V. Stocklein who then and there acknowledged the making and signing of the foregoing plat to be his voluntary act and deed for the uses and purposes thereon shown.
Witness my hand and seal this 20th day of October 1903.

Lawrence G. Vornstell
Notary Public

Transferred Oct. 20th 1903.
E. P. Walker
Auditor
Received for record Oct. 20th 1903 at 25 cents
277.
Oct 23rd 1903
E. Allen

J. ALLEN