


FOH-4511 (37)

All drawings and data of this right-of-way and all distances shown herein are based on the original survey of the right-of-way and are not to be construed as a warranty of any kind.

AUTHORITY	DATE INSTALLED OR REFERRED	DESCRIPTION

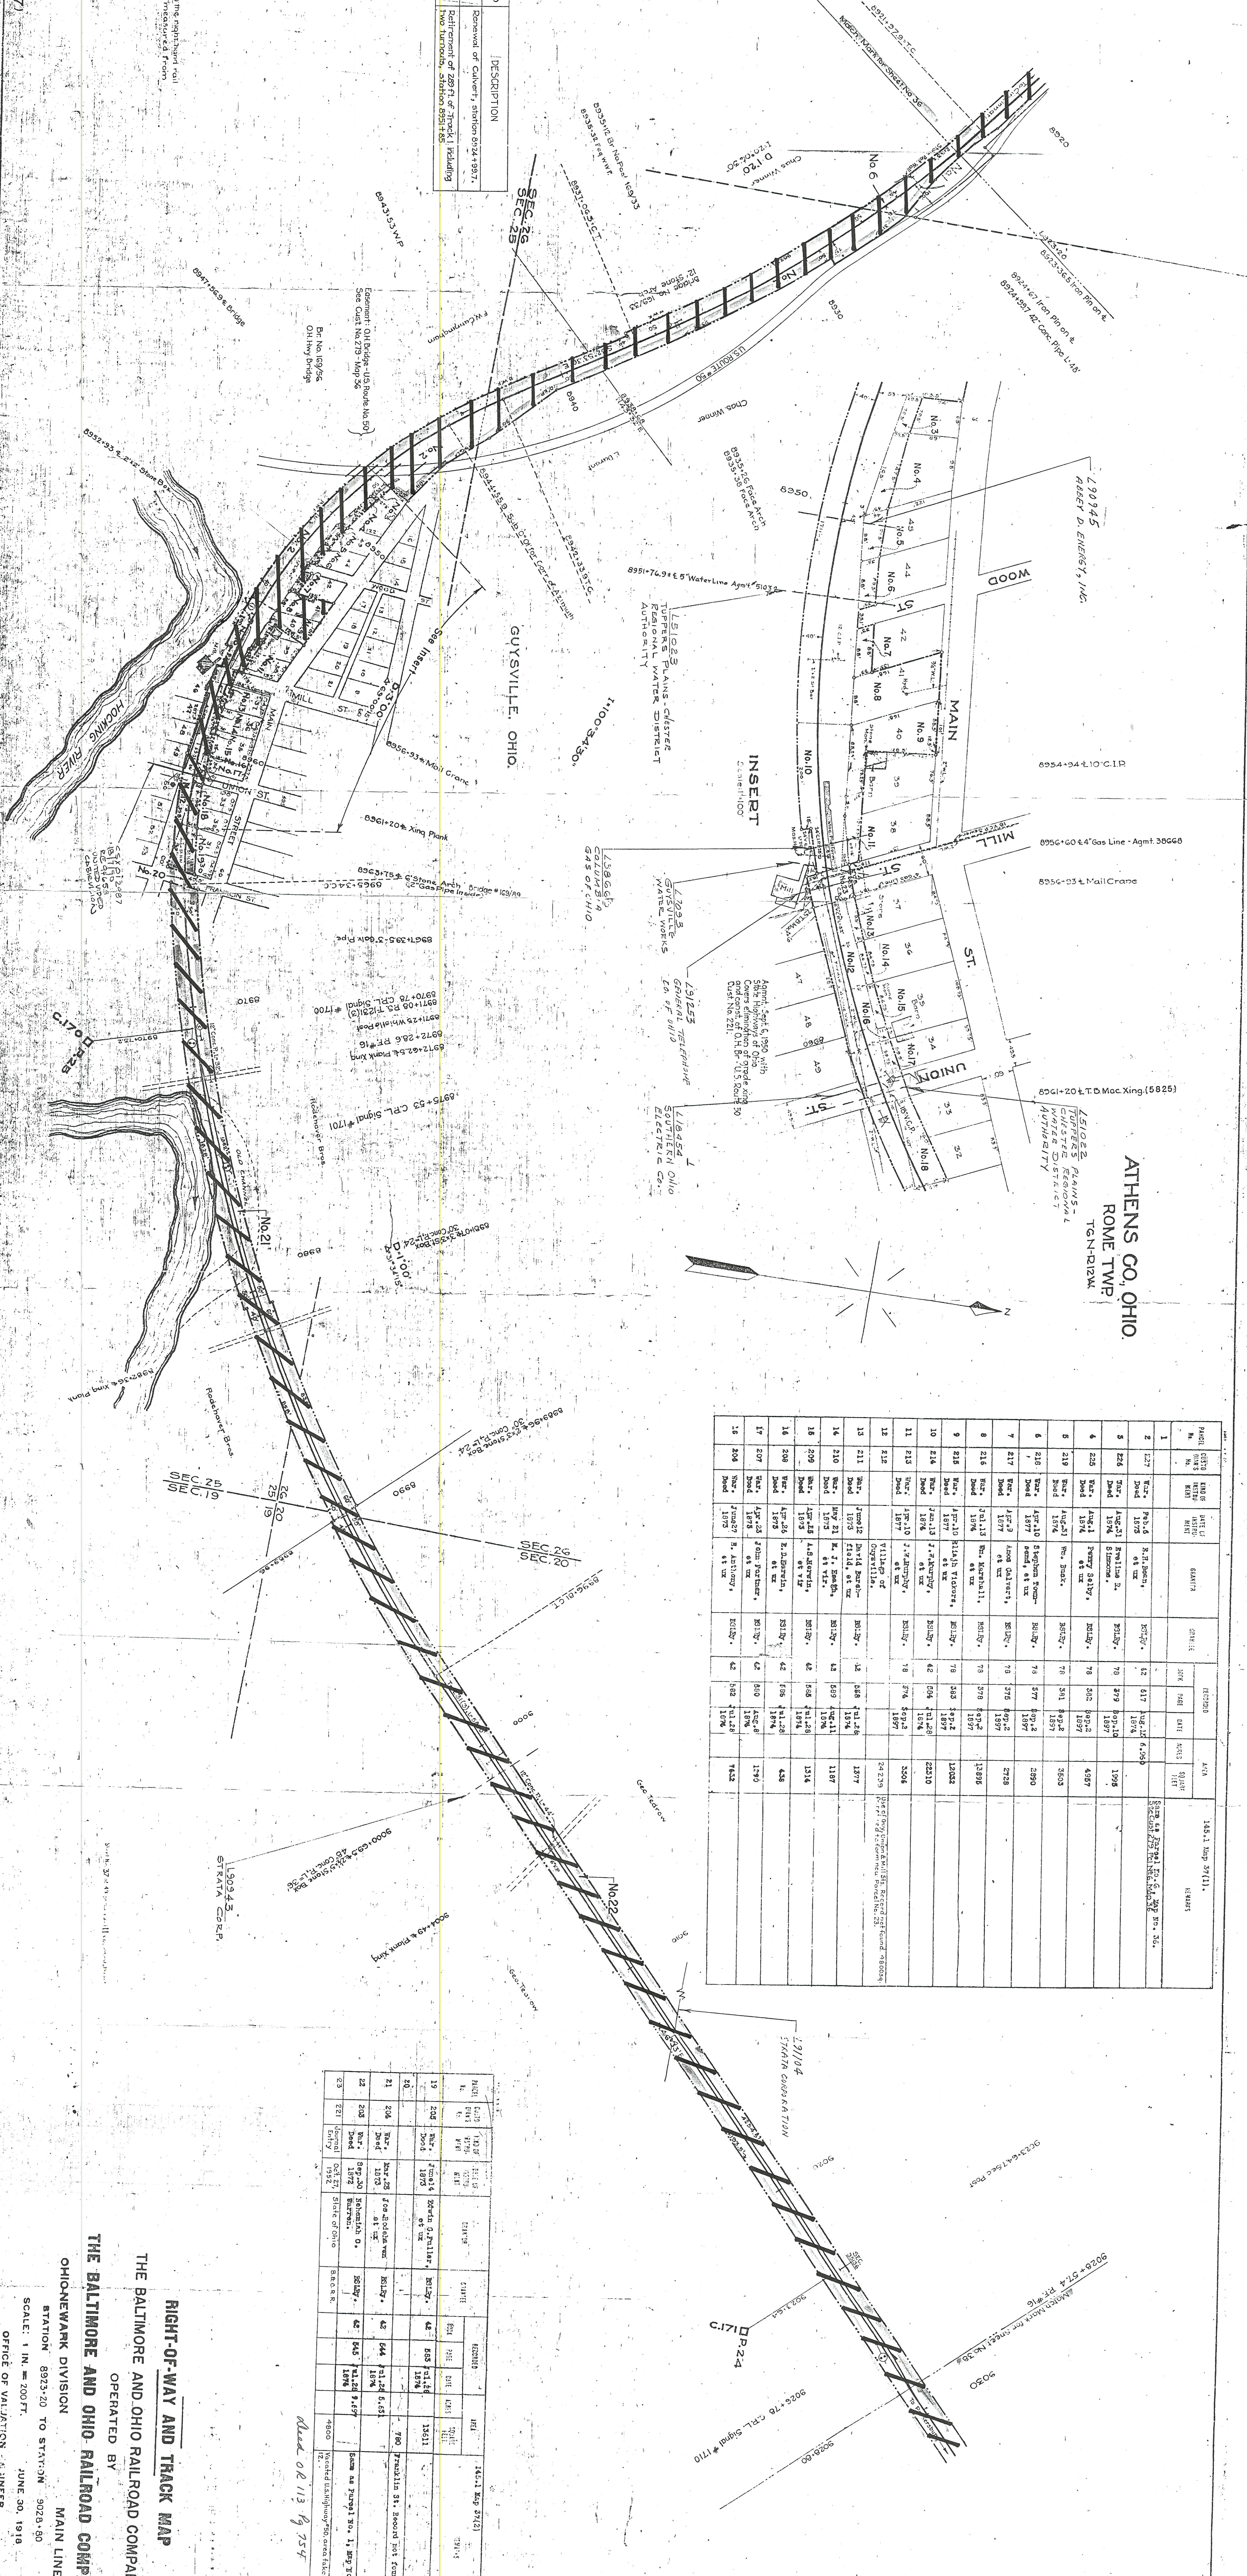

ATHENS CO., OHIO  
ROME TWP  
T.C.M.-122M

RIGHT-OF-WAY AND TRACK MAP  
THE BALTIMORE AND OHIO RAILROAD COMPANY  
OPERATED BY  
THE BALTIMORE AND OHIO RAILROAD COMPANY  
OHIOEWAARK DIVISION  
SCALE: 1 IN. = 200 FT.  
OFFICE OF VALUATION, ENGINEER  
BALTIMORE, MD.  
JUNE 30, 1918