

DESCRIPTION OF 5.0950 ACRES

Situated in the east one-half of the northwest quarter of Section 11, Town 10, Range 15, Lee Township, Athens County Ohio and being more particularly described as follows:

Commencing at the southeast corner of said northwest quarter' thence along the south line of said quarter south $88^{\circ} 25' 30''$ west 913.19 feet to an iron pin set at the point of beginning of the tract herein described; thence continuing south $88^{\circ} 25' 30''$ west 258.68 feet to an iron pin found; thence leaving said south line north $22^{\circ} 52' 53''$ east 979.32 feet to an iron pin found; thence south $67^{\circ} 07' 32''$ east 244.51 feet to an iron pin set; thence south $23^{\circ} 28' 30''$ west 872.30 feet to the point of beginning containing 5.0950 acres.

Prior deed Reference: Volume 322, Page 303, Athens County Deed Records.

Prepared by: Evans, Mechwart, Hambleton & Tilton, Inc.

Registered Surveyor #6535

61

LEE#11



Robert E. & Patricia S.
Preston
329-809

Ted & Evelyn Joyce
Mullins
322-303


5.0950
Acres

N 72° 52' 53" E
979.32'

567° 07' 32" E
744.51'

872.30'
S 73° 28' 30" W

James Eddie
Darst
329-85

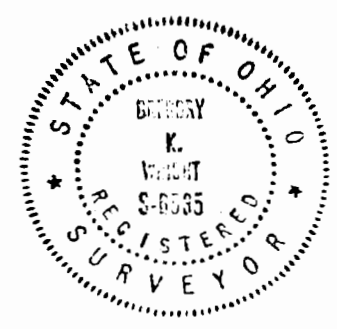

PLAT OF SURVEY
5.0950 ACRES

LOCATED IN SECTION 11, TOWN 10,
RANGE 15, LEE TOWNSHIP, ATHENS
COUNTY OHIO
SCALE 1" = 100' January, 1982
FOR TED MULLINS

PREPARED BY
EVANS, MECHWART, HAMBLETON & TILTON,
CONSULTING ENGINEERS AND SURVEYORS
GAHANNA, OHIO ATHENS, OHIO

258.68'
S 38° 25' 50" W
Ronald H. & Barbara K.

IP set 413.19'

Gregory K. Wright
Registered Surveyor #6535