


LINE TABLE		
LINE	BEARING	LENGTH
L1	N24°45'14"W	119.66'
L2	N84°16'31"W	65.00'

Existing home - no additional buildings made  
 ok. to transfer  
 per Athens City - Co  
 Health Dept.  
 "sewage system application  
 pending / easement from  
 off-lot discharge will  
 be simultaneously  
 recorded w/ this  
 plat"  
 Charles Paul  
 4/14/00

43,560 sq. ft.  
 1.000 acres

"Approved by the Athens  
 County Regional Planning  
 Commission; No plat  
 Required"

*Bob Schenberg*  
 Planning Director  
 Date 4/14/00  
 by PAM

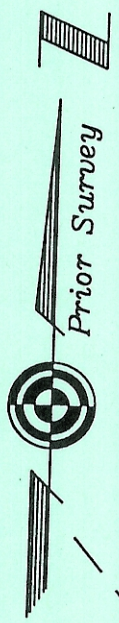

Charles Paul & Maugarite  
 Kostival  
 280-40 OR

Charles Paul & Maugarite

Scale: 1" = 50'

Co. Rd. 10  
 Twp. Rd. 15

Gregory K. Wright  
 Professional Engineer  
 Professional Surveyor  
 11684 Channingway Blvd  
 The Plains, Ohio 45780  
 740-797-4142  
 FAX 740-797-8623

C:\Land Projects R2\PKostival\dwg\Dave White mtg.dwg 03/13/00 08:37:42 PM EST

I hereby declare that the foregoing was prepared from an actual mortgage survey of the premises and correctly shows the location of buildings and drives. THIS PLAT WAS PREPARED FOR MORTGAGE LOAN AND TITLE PURPOSES ONLY AND IS NOT TO BE CONSTRUED AS HAVING BEEN PREPARED FOR THE OWNER FOR ANY PURPOSE.

Owner: David White  
 Property Address: 5340 Baker Road  
 Athens, Ohio 45701  
 Located in Section 12, Lee Township, Athens County, Ohio

*Gregory K. Wright*

