



SCALE: 1" = 200'


- ⊙ = IRON PIN
- = TREE
- = P.K. NAIL
- ⊙ = POST
- ⊗ = STONE

BEING A PART OF SECTIONS 16, 17, 22, AND 23, TOWNSHIP 10, RANGE 15, LEE TOWNSHIP, ATHENS COUNTY, OHIO.

LEE TWP 10 R 15
 87.48 Ac 17
 87.61 Ac 22
 4.86 Ac 16

I HEREBY CERTIFY THAT AN ACTUAL SURVEY WAS MADE BY STEVEN C. SKINNER UNDER MY SUPERVISION OF THE PREMISES SHOWN HEREON ON THE 7TH DAY OF APRIL 1980 AND THAT THE PLAT IS A CORRECT REPRESENTATION OF THE PREMISES AS DETERMINED BY SAID SURVEY.

 REGISTERED SURVEYOR NO. 6535

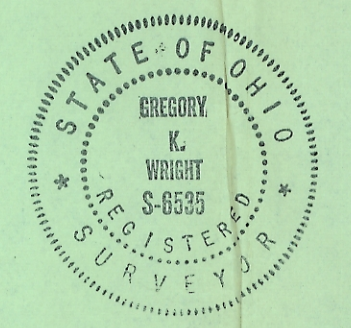

REVISIONS			KEEPER SURVEY		
NO.	DATE	BY	DRAWN BY	SCALE	MATERIAL
1			S.C.S.	1" = 200'	
2					
3			CHK'D	DATE	DRAWING NO.
4			TRACED	APP'D	
5					