PROFESSIONAL LAND SURVEYORS

SEYMOUR & ASSOCIATES

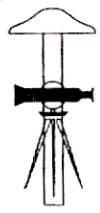

P.O. Box 624
830 W. Hunter St. 614-385-4349
Logan, Ohio 43138

PLAT OF SURVEY

BEING A PART OF FRACTION 19, SECTION 20, TOWNSHIP-4-NORTH, RANGE-13-WEST, LODI TOWNSHIP, ATHENS COUNTY, STATE OF OHIO

STATE OF OHIO
GEORGE F. SEYMOUR S-6044
REGISTERED SURVEYOR

DATE: 12-27-99

BY: C.T.S.

FOR: VERNA HEAVENER

PROJ. NO.: AT9933

NOTE: BEARINGS WERE DERIVED FROM MAGNETIC TAKEN ON 12-22-99 AND ARE FOR THE DETERMINATION OF ANGLES ONLY.

SCALE 1" = 200'

0 100 200 400

LEGEND

△ - 5/8"x30" IRON PIN W/ID CAP SET
▲ - EXISTING IRON PIN
- 18" WALNUT TREE
• - POINT

REFERENCES

CURRENT TAX PLATS
PREVIOUS SURVEYS
DEEDS: AS NOTED ON PLAT

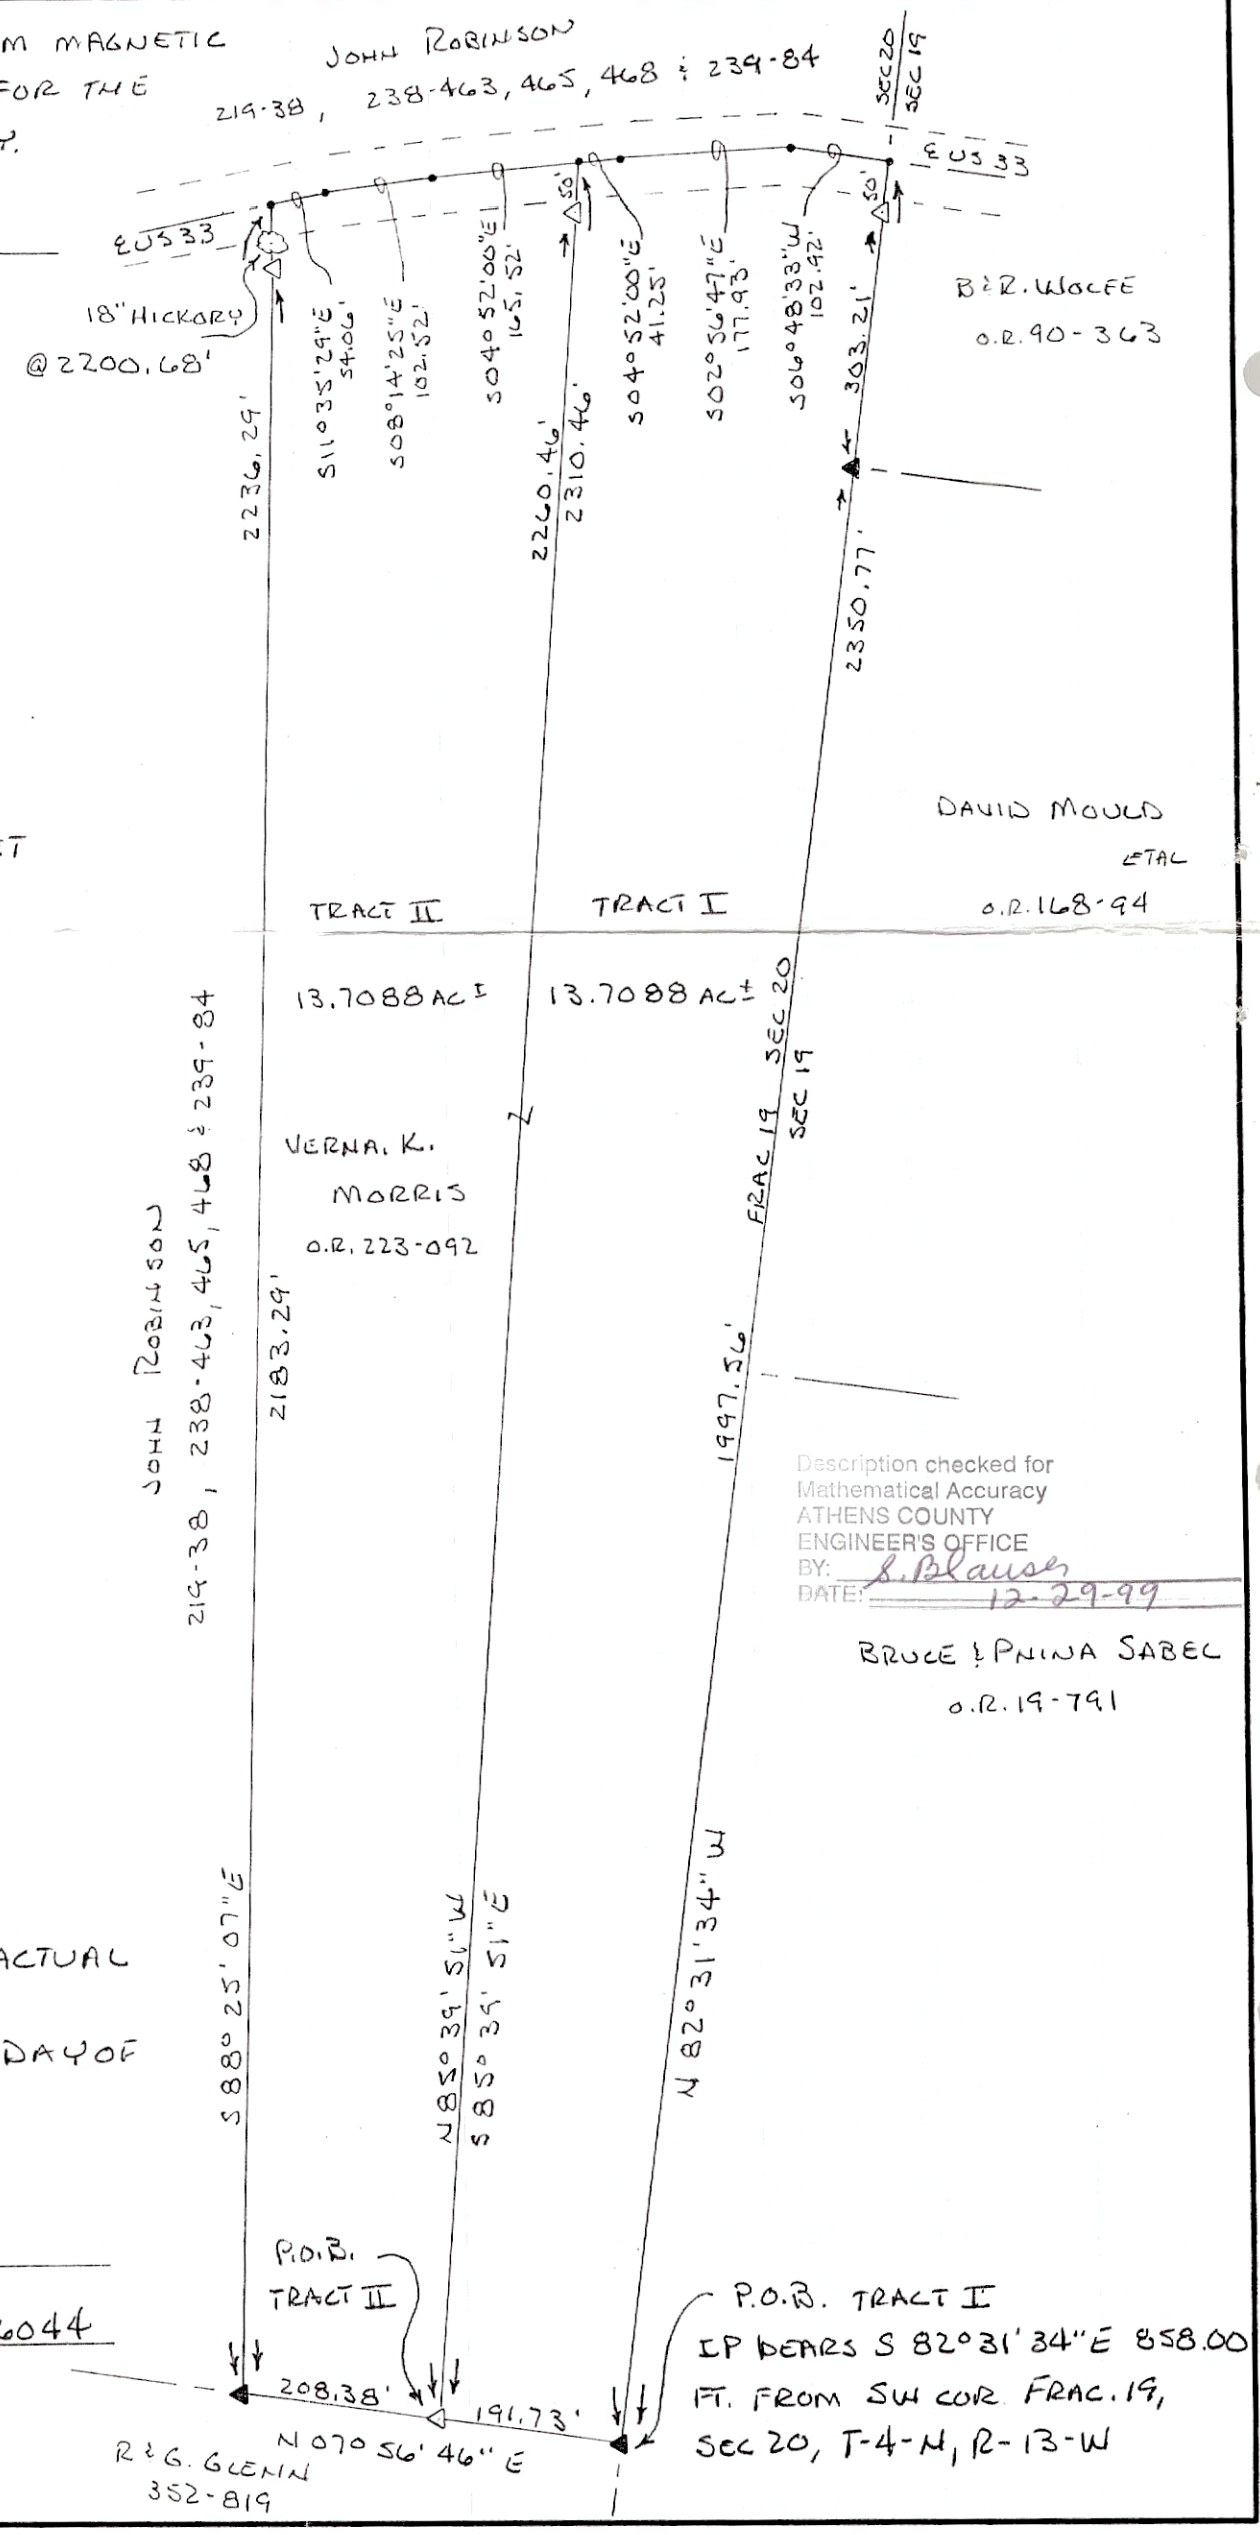

PLAT PREPARED FROM AN ACTUAL SURVEY MADE ON THE 27th DAY OF DECEMBER, 1999 BY,

George F. Seymour

OHIO PROFESSIONAL SURVEYOR NO. 6044