


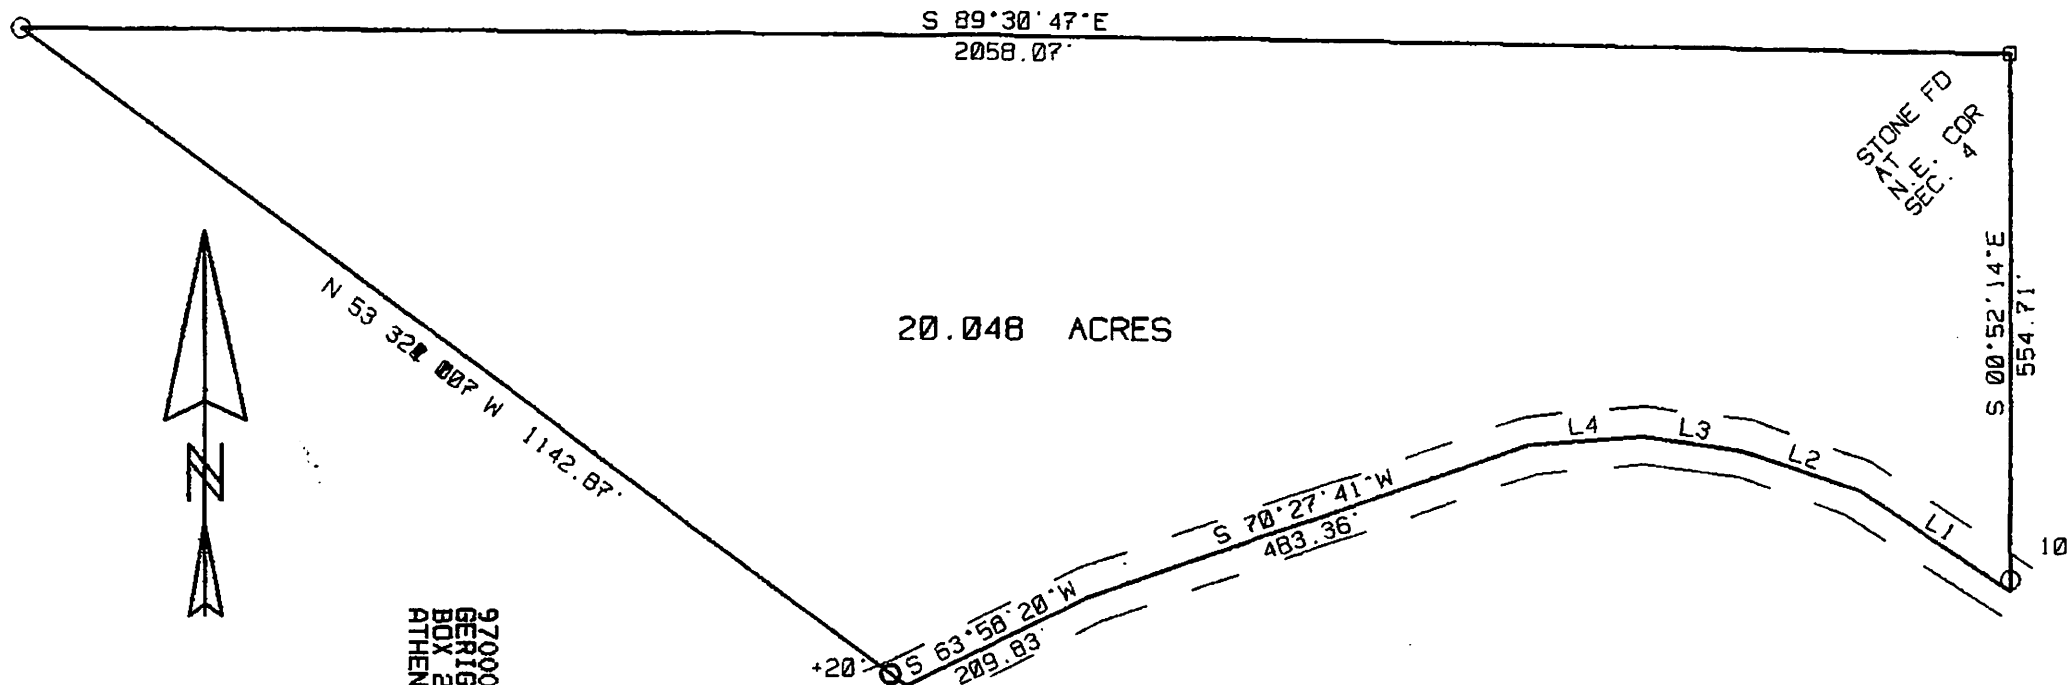

20.048 ACRES

9700003197
GERIG AND GERIG
BOX 268
ATHENS, OH 45701

SCALE 1 INCH = 200 FEET
O = IRON PIN SET
ASSUMED BEARINGS

TWP RD 102

LINE	BEARING	DISTANCE
L 1	N 57°30'32"W	191.98'
L 2	N 72°15'28"W	126.31'
L 3	N 81°32'45"W	103.86'
L 4	S 85°02'49"W	118.71'
L 5	S 72°05'46"W	80.86'

SURVEY OF A 20.048 ACRE TRACT
IN SECTION 4, T.4, R.13.
LODI TOWNSHIP, ATHENS CO., O.
SURVEYED APRIL 1997

John M. Branner
JOHN M. BRANNER P.S. 6805
12500 N. PEACH RIDGE ROAD
ATHENS, OHIO 614-592-5778

J. Branner
4-29-97

