ENVELOPE: 223B

MICHAELS 4th ADDITION
VERITY
SECTION 18 & 24
ATHENS TWP

MAP OF THE MICHAEL'S FOURTH ADDITION TO VERITY

Michael additions to Verity are situate in the north part of Lease Lots Nos. 111 and 113, Sections Nos. 18 and 24, Town No. 9, Range No. 14, of the Ohio University Leasehold Lands and contains the acreages and lots numbered as shown in "Table" below.

Scale 1 inch = 50 feet.
C. E. Biddison, Eng.

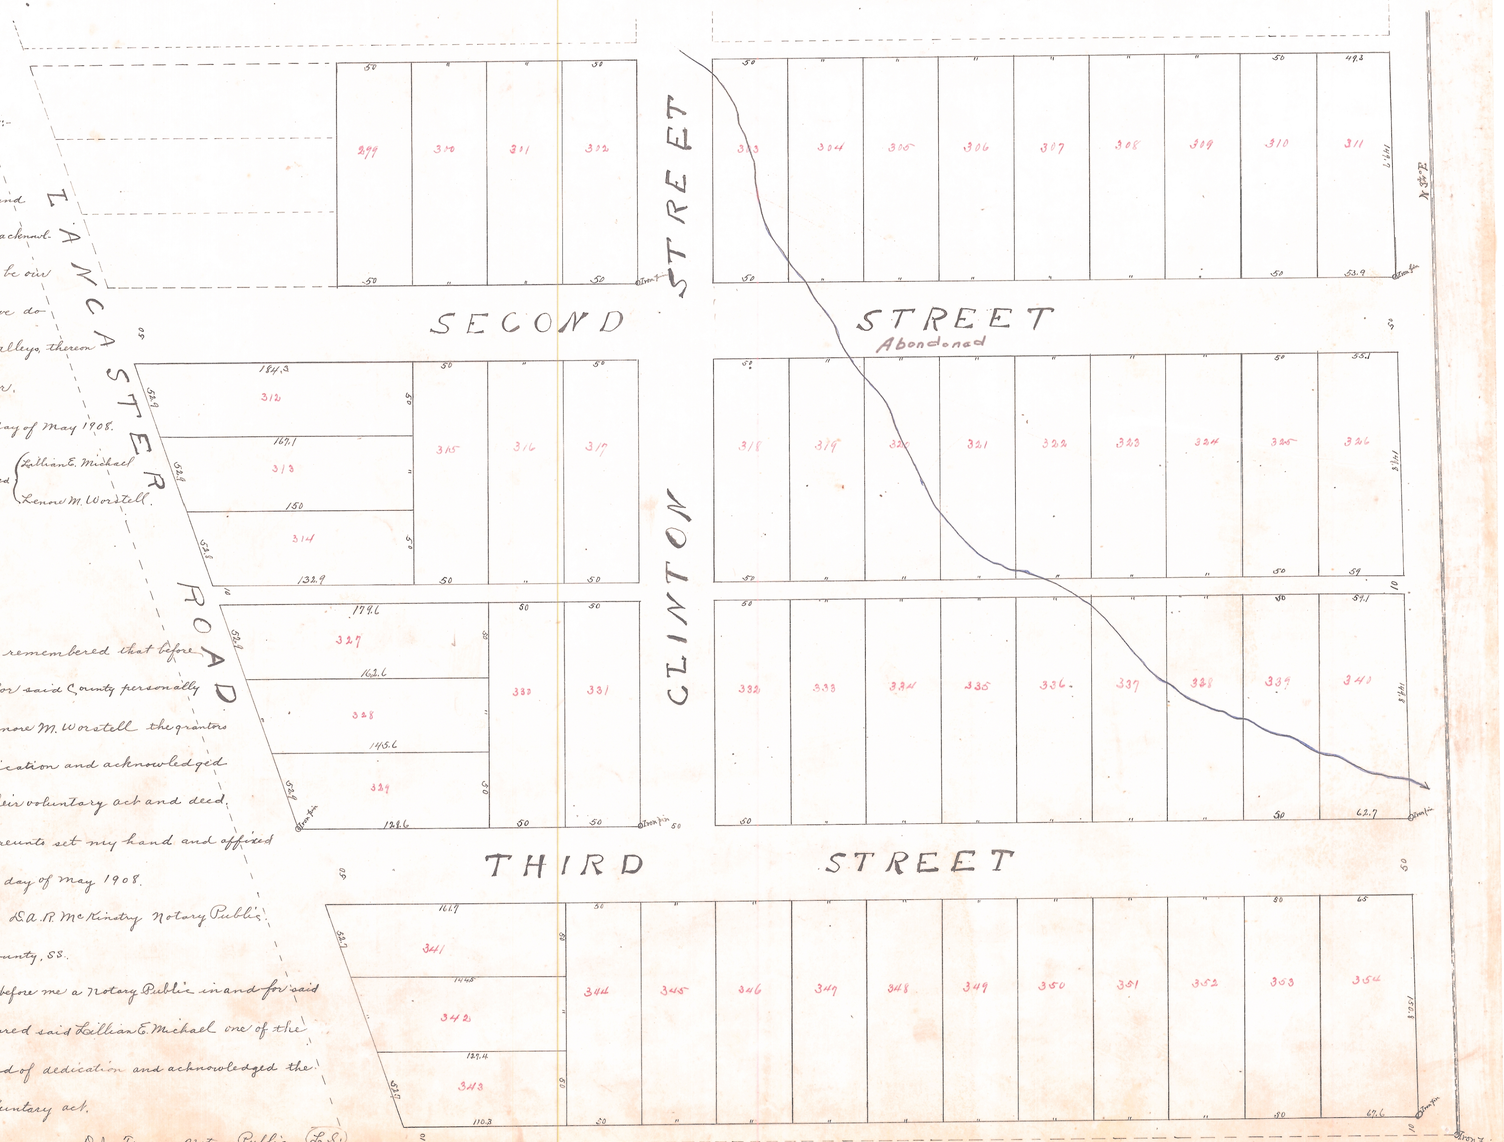

Know all men by these presents:- That we Lillian E. Michael and Lenore M. Worstell owners of the land delineated on this plat do hereby acknowledge the making of the same to be our voluntary act and deed:- And we do hereby dedicate the streets and alleys, thereon shown to and for public use forever.

Witness our hands this 1st day of May 1908.

Grace M. Stickney } witnesses to signature of Lenore M. Worstell
D. A. R. McKinstry } Signed { Lillian E. Michael, Lenore M. Worstell.

D. J. Troyer } Witnesses to signature of Lillian E. Michael.
Belle Weinstein

The State of Ohio } SS.
Athens County

Be it remembered that before me a Notary Public in and for said County personally came Lillian E. Michael and Lenore M. Worstell the grantors in the foregoing deed of dedication and acknowledged the signing thereof to be their voluntary act and deed.

In Witness whereof, I have hereunto set my hand and affixed my Notarial seal on this 7th day of May 1908.

(L.S.) D. A. R. McKinstry Notary Public.

The State of Indiana, Elkhart County, SS.

On this 1st day of May 1908 before me a Notary Public in and for said Elkhart county personally appeared said Lillian E. Michael one of the grantors in the foregoing deed of dedication and acknowledged the signing there of to be her voluntary act.

D. J. Troyer Notary Public. (L.S.)
My. com. ex. 3/6-09 My commission expires

Transfer not necessary. 7 day of May 1908.
H. H. Haning,
Treas. D.U.

Transferred this 7th day of May 1908.
E. R. Walker
Auditor

Presented for Record this 1st day of July 1908. Oclock & A.M.
Recorded this 15th day of August - 1908