


C. TIM NEWMAN  
Professional Surveyor

66 Elmwood Place  
Athens, Ohio 45701

740-594-1884  
740-591-5269

Plat of Survey of 38.388 Acres  
Situate Ohio Company Purchase Town 11, Range 14, Section 18,  
Trimble Township, Athens County, Ohio.  
Being all of the lands deeded to:  
David M. Arbogast, Official Record Book 556 pages 2589-2591.

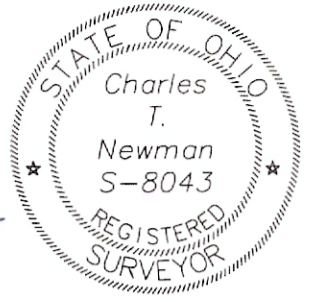

*Charles T. Newman*  
Charles T. Newman  
Surveyed 3/24/2021

Description Checked for  
Mathematical Accuracy  
Athens County  
ENGINEER'S OFFICE  
BY: *David E. SW*  
DATE: *3/26/21*

U.S.A. 62-225  
S 85°31'46" E  
1080.87'  
+336.28'  
+610.50'  
+813.16'  
+1010.00'  
Arbogast 556-2589  
38.388 ACRES

LINE TABLE		
LINE	BEARING	LENGTH
L1	S47°54'08"W	42.89'
L2	N14°52'36"W	410.06'
L3	N83°43'18"E	54.49'
L4	N18°32'46"W	432.28'
L5	S58°28'20"W	207.78'
L6	N42°16'21"W	81.37'
L7	N43°03'54"E	150.00'
L8	N43°37'19"W	248.84'
L9	N37°24'13"E	70.98'
L10	N60°43'07"W	188.23'

- Iron Pin capped CLS 7224
- ▲ Railroad Rail
- ▲ 1.5" Diameter Steel scribed X
- Iron Pin Found cap is unreadable
- Iron Pin Set capped NEWMAN
- 6" Steel Channel Beam
- 2"x2" Hub Found

CURVE TABLE				
CURVE	RADIUS	LENGTH	BEARING	CHORD
C1	921.88	439.31'	S 05°08'55" E	435.17'
C2	1010.60	104.04'	S 11°27'02" W	103.99'

GRAPHIC SCALE



( IN FEET )  
1 inch = 200 ft.

